


# EXHIBIT B SECTION MAPS



1" = 1,000'

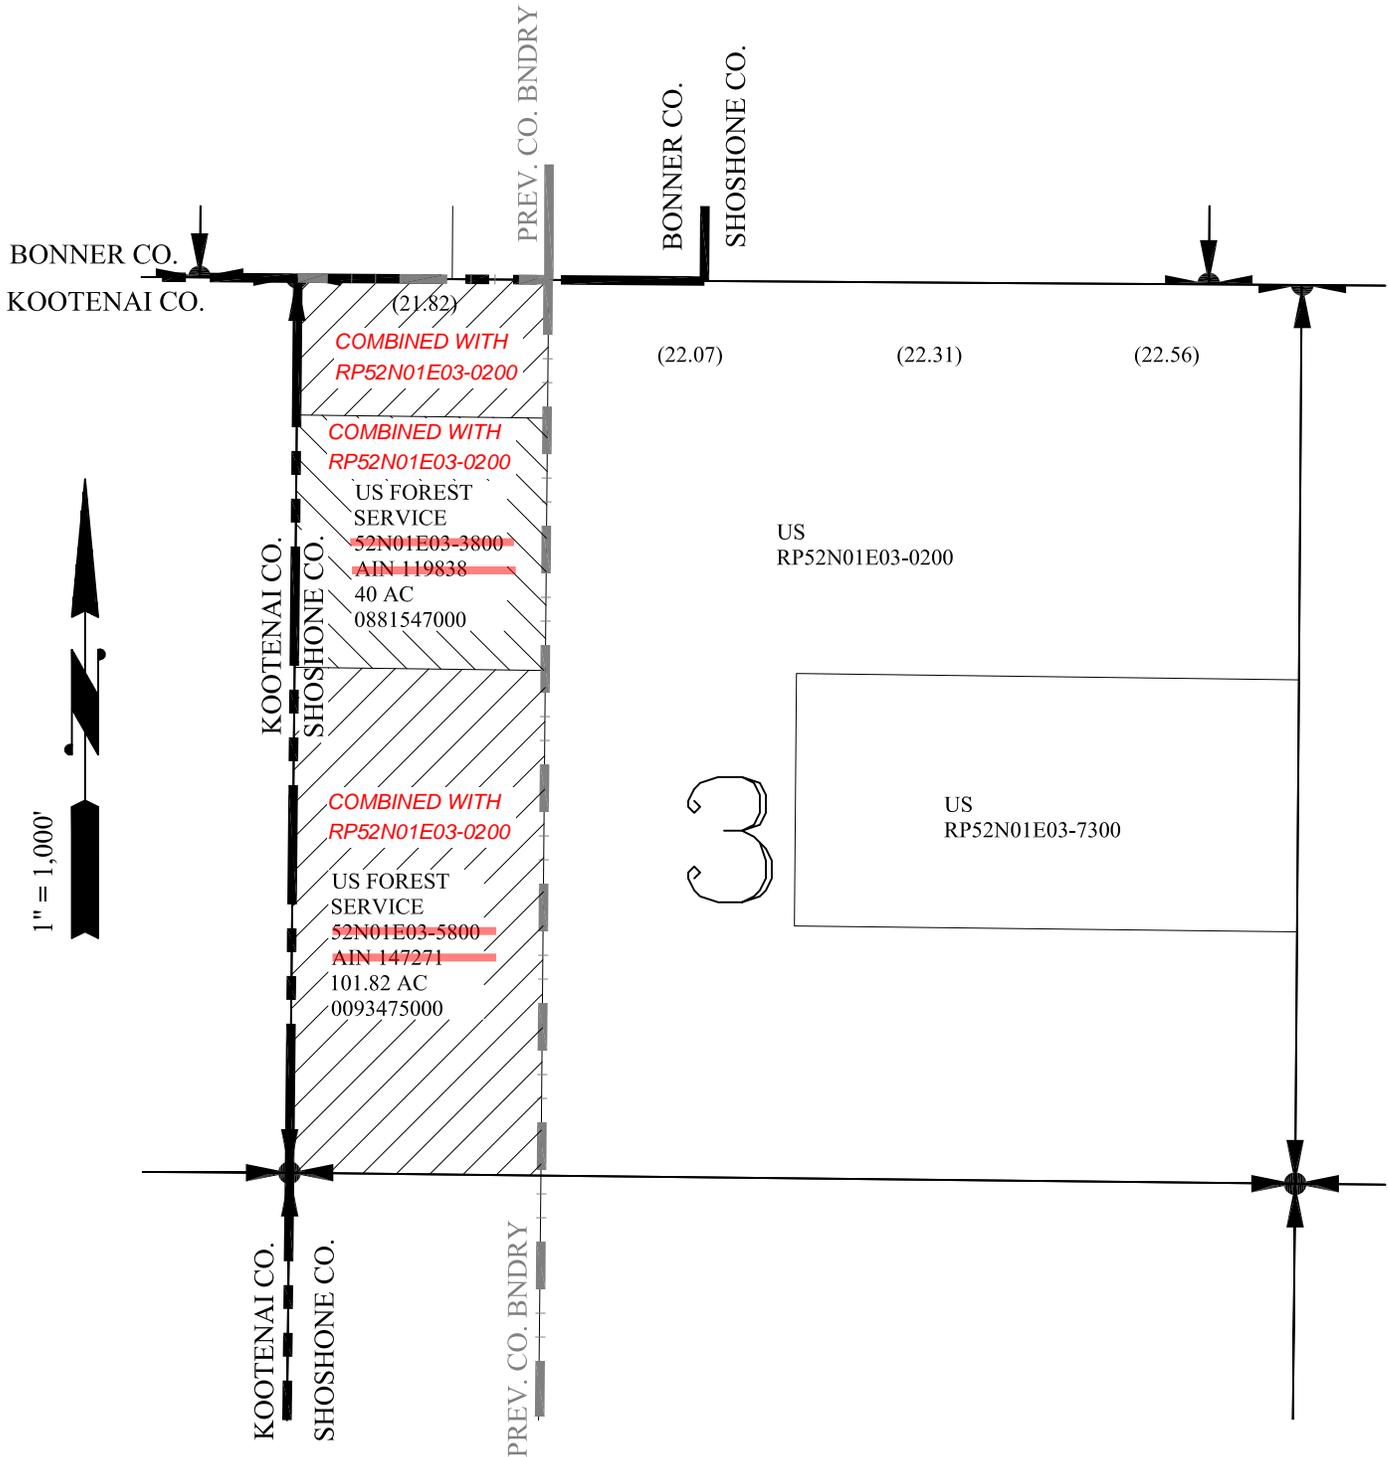

ALL OF  
52N01E03-5800  
NOW LYING IN  
SHOSHONE CO.



ALL OF  
52N01E03-3800  
NOW LYING IN  
SHOSHONE CO.

SEC 03, T52N, R1E

1" = 1,000'



KOOTENAI CO.

SHOSHONE CO.

PREV. CO. BNDRY

KOOTENAI CO.

SHOSHONE CO.

PREV. CO. BNDRY

US FOREST SERVICE

~~52N01E10-5600~~

~~AIN 121210~~

160 AC  
0881547000

COMBINED WITH  
RP52N01E10-0200

US  
RP52N01E10-0200

10



ALL OF  
52N01E10-5600  
NOW LYING IN  
SHOSHONE CO.

SEC 10, T52N, R1E

1" = 1,000'



KOOTENAI CO.

SHOSHONE CO.

PREV. CO. BNDRY

KOOTENAI CO.

SHOSHONE CO.

PREV. CO. BNDRY

US FOREST SERVICE

~~52N01E15-5600~~

~~AIN 103516~~

160 AC

COMBINED WITH  
RP52N01E15-0200

15

US  
RP52N01E15-0200



ALL OF  
52N01E15-5600  
NOW LYING IN  
SHOSHONE CO.

SEC 15, T52N, R1E

1" = 1,000'



KOOTENAI CO.

SHOSHONE CO.

PREV. CO. BNDRY

US FOREST SERVICE  
~~52N01E22-5800~~  
~~AIN 146881~~  
COMBINED WITH  
RP52N01E22-0200

COMBINED WITH  
RP52N01E22-0200

US FOREST SERVICE  
~~52N01E22-3800~~  
~~AIN 101922~~  
40 AC  
1397020

US  
RP52N01E22-0200

22

KOOTENAI CO.

SHOSHONE CO.

PREV. CO. BNDRY

US FOREST SERVICE  
~~52N01E22-5800~~  
~~AIN 146881~~  
120 AC

COMBINED WITH  
RP52N01E22-0200



ALL OF  
52N01E22-5800  
NOW LYING IN  
SHOSHONE CO.



ALL OF  
52N01E22-3800  
NOW LYING IN  
SHOSHONE CO.

SEC 22, T52N, R1E

1" = 1,000'



KOOTENAI CO.

SHOSHONE CO.

PREV. CO. BNDRY

KOOTENAI CO.

SHOSHONE CO.

PREV. CO. BNDRY

US FOREST SERVICE

~~52N01E27-5600~~

~~AIN 108509~~

160 AC

COMBINED WITH  
RP52N01E27-0200

27

US  
RP52N01E27-0200



ALL OF  
52N01E27-5600  
NOW LYING IN  
SHOSHONE CO.

SEC 27, T52N, R1E

1" = 1,000'



KOOTENAI CO.

SHOSHONE CO.

PREV. CO. BNDRY

KOOTENAI CO.

SHOSHONE CO.

PREV. CO. BNDRY

US FOREST SERVICE

~~52N01E34-5600~~

~~AIN 104426~~

160 AC

COMBINED WITH  
RP52N01E34-0200

US  
RP52N01E34-0200

34



ALL OF  
52N01E34-5600  
NOW LYING IN  
SHOSHONE CO.

SEC 34, T52N, R1E

1" = 1,000'



KOOTENAI CO.

SHOSHONE CO.

PREV. ASSESSED BNDRY

PREV. CO. BNDRY

KOOTENAI CO.

SHOSHONE CO.

PREV. ASSESSED BNDRY

PREV. CO. BNDRY

(40.08)

(40.10)

(40.10)

(40.12)

US FOREST SERVICE

~~51N01E03-3200~~

~~AIN 134679~~

160.08 AC

COMBINED WITH  
RP51N01E03-0200

US  
RP51N01E03-0200

3



ALL OF  
51N01E03-3200  
NOW LYING IN  
SHOSHONE CO.

SEC 03, T51N, R1E

1" = 1,000'



KOOTENAI CO.

SHOSHONE CO.

PREV. ASSESSED BNDRY

PREV. CO. BNDRY

KOOTENAI CO.

SHOSHONE CO.

PREV. ASSESSED BNDRY

PREV. CO. BNDRY

US FOREST SERVICE  
~~51N01E10-3200~~  
~~AIN 118372~~  
160 AC

COMBINED WITH  
RP51N01E10-0200

US  
RP51N01E10-0200

10



ALL OF  
51N01E10-3200  
NOW LYING IN  
SHOSHONE CO.

SEC 10, T51N, R1E

1" = 1,000'



KOOTENAI CO.

SHOSHONE CO.

PREV. ASSESSED BNDRY

PREV. CO. BNDRY

KOOTENAI CO.

SHOSHONE CO.

PREV. ASSESSED BNDRY

PREV. CO. BNDRY

US FOREST SERVICE

~~51N01E15-3200~~

~~AIN 113412~~

160 AC

COMBINED WITH  
RP51N01E15-0200

15

US  
RP51N01E15-0200



ALL OF  
51N01E15-3200  
NOW LYING IN  
SHOSHONE CO.

SEC 15, T51N, R1E

1" = 1,000'



KOOTENAI CO.

SHOSHONE CO.

PREV. ASSESSED BNDRY

PREV. CO. BNDRY

KOOTENAI CO.

SHOSHONE CO.

PREV. ASSESSED BNDRY

PREV. CO. BNDRY

US FOREST SERVICE

~~51N01E22-3200~~

~~AIN 133666~~

160 AC

COMBINED WITH  
RP51N01E22-0200

22

US  
RP51N01E22-0200



ALL OF  
51N01E22-3200  
NOW LYING IN  
SHOSHONE CO.

SEC 22, T51N, R1E

1" = 1,000'



KOOTENAI CO.

SHOSHONE CO.

PREV. ASSESSED BNDRY

PREV. CO. BNDRY

KOOTENAI CO.

SHOSHONE CO.

PREV. ASSESSED BNDRY

PREV. CO. BNDRY

US FOREST SERVICE  
~~51N01E27-3200~~  
~~AIN 112600~~  
160 AC

COMBINED WITH  
RP51N01E27-0200

US  
RP51N01E27-0200

27



ALL OF  
51N01E27-3200  
NOW LYING IN  
SHOSHONE CO.

SEC 27, T51N, R1E

1" = 1,000'



KOOTENAI CO.

SHOSHONE CO.

PREV. ASSESSED BNDRY

PREV. CO. BNDRY

US FOREST SERVICE

~~51N01E34-3200~~

~~AIN 125654~~

160 AC

COMBINED WITH  
RP51N01E34-0200

US  
RP51N01E34-0200

34

PREV. ASSESSED BNDRY

PREV. CO. BNDRY

KOOTENAI CO.

SHOSHONE CO.



ALL OF  
51N01E34-3200  
NOW LYING IN  
SHOSHONE CO.

SEC 34, T51N, R1E

1" = 1,000'



KOOTENAI CO.

SHOSHONE CO.

PREV. ASSESSED BNDRY

PREV. CO. BNDRY

US FOREST SERVICE  
50N01E03-3200  
AIN 133836  
160 AC

50N01E03-2500  
(NEW KC#)

US  
RP50N01E03-0200

PREV. ASSESSED BNDRY

PREV. CO. BNDRY

KOOTENAI CO.


SHOSHONE CO.



160 AC OF  
RP50N01E03-0200  
NOW LYING IN  
KOOTENAI CO.  
320 AC REMAINDER  
IN SHOSHONE

SEC 03, T50N, R1E

1" = 1,000'

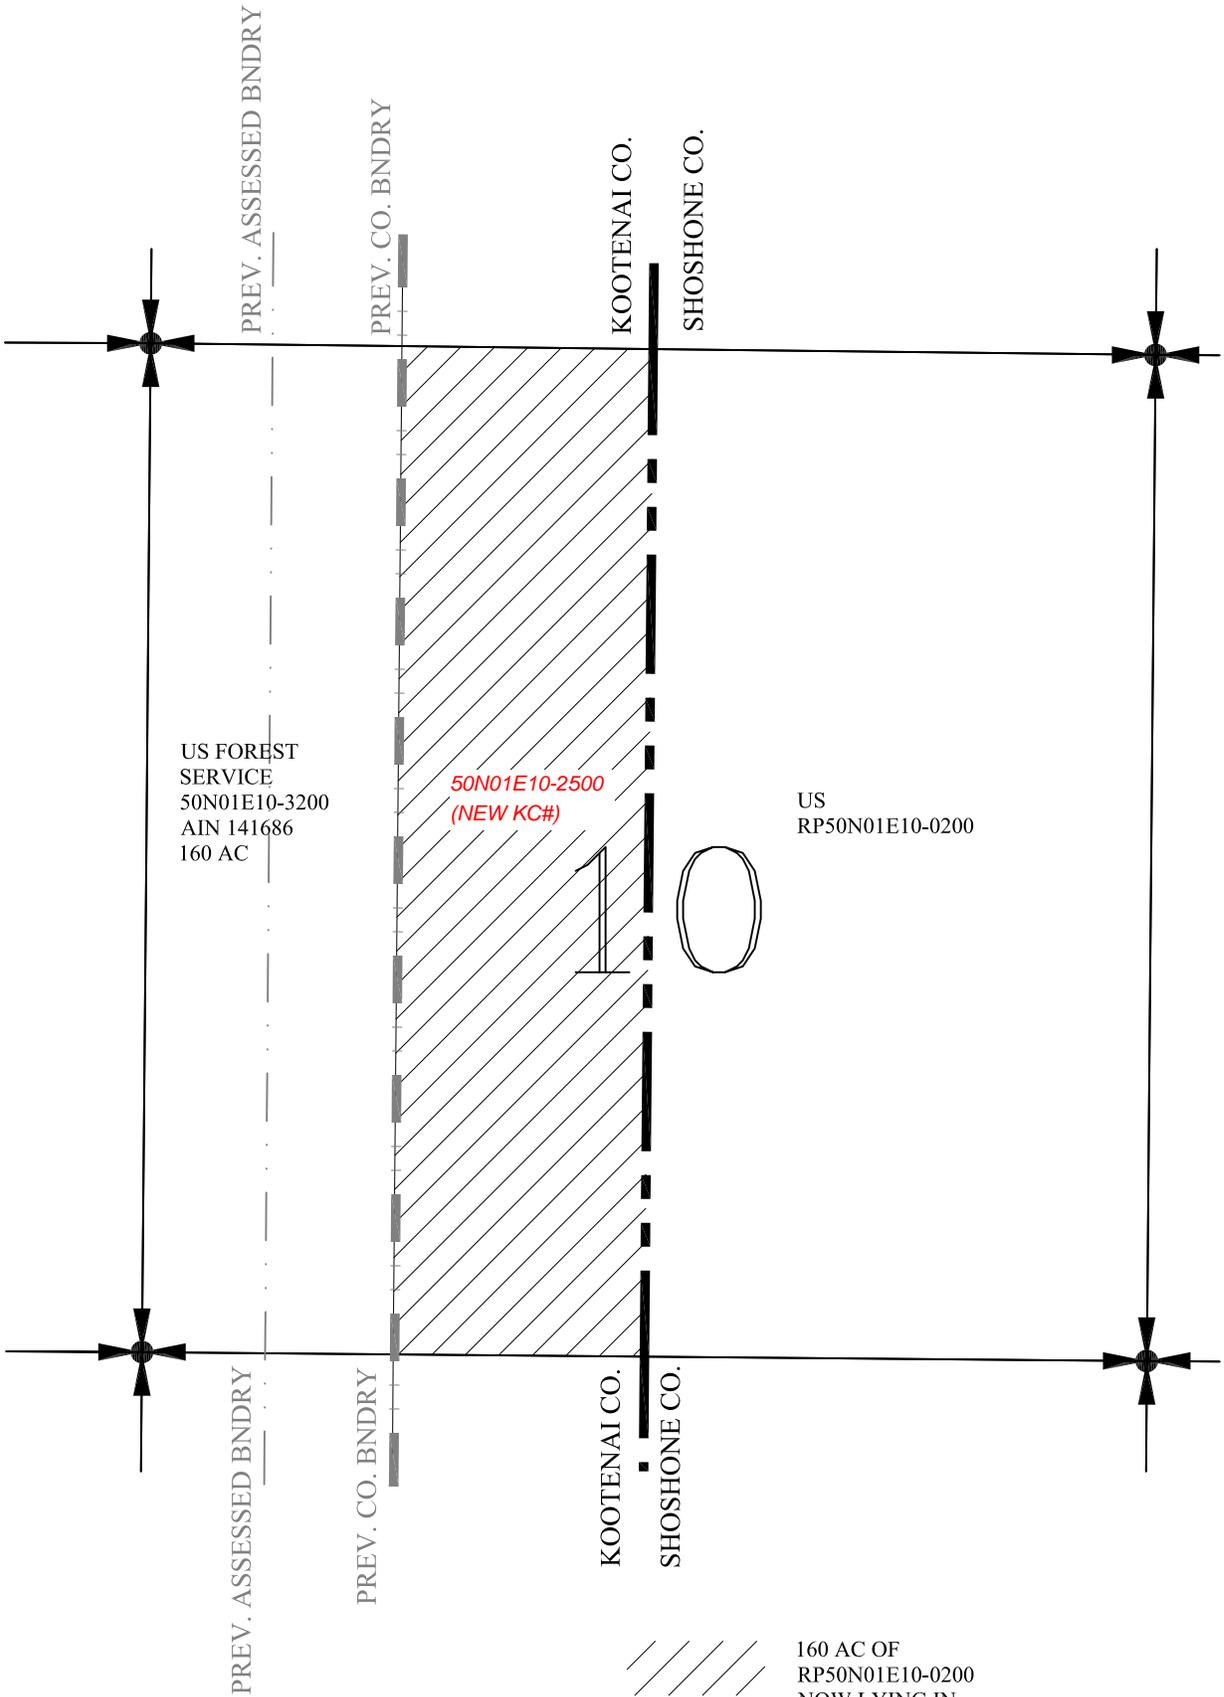

US FOREST SERVICE  
50N01E10-3200  
AIN 141686  
160 AC

50N01E10-2500  
(NEW KC#)

US  
RP50N01E10-0200

PREV. ASSESSED BNDRY

PREV. CO. BNDRY

KOOTENAI CO.

SHOSHONE CO.

PREV. ASSESSED BNDRY

PREV. CO. BNDRY

KOOTENAI CO.


SHOSHONE CO.



160 AC OF  
RP50N01E10-0200  
NOW LYING IN  
KOOTENAI CO.  
320 AC REMAINDER  
IN SHOSHONE

# SEC 10, T50N, R1E

1" = 1,000'

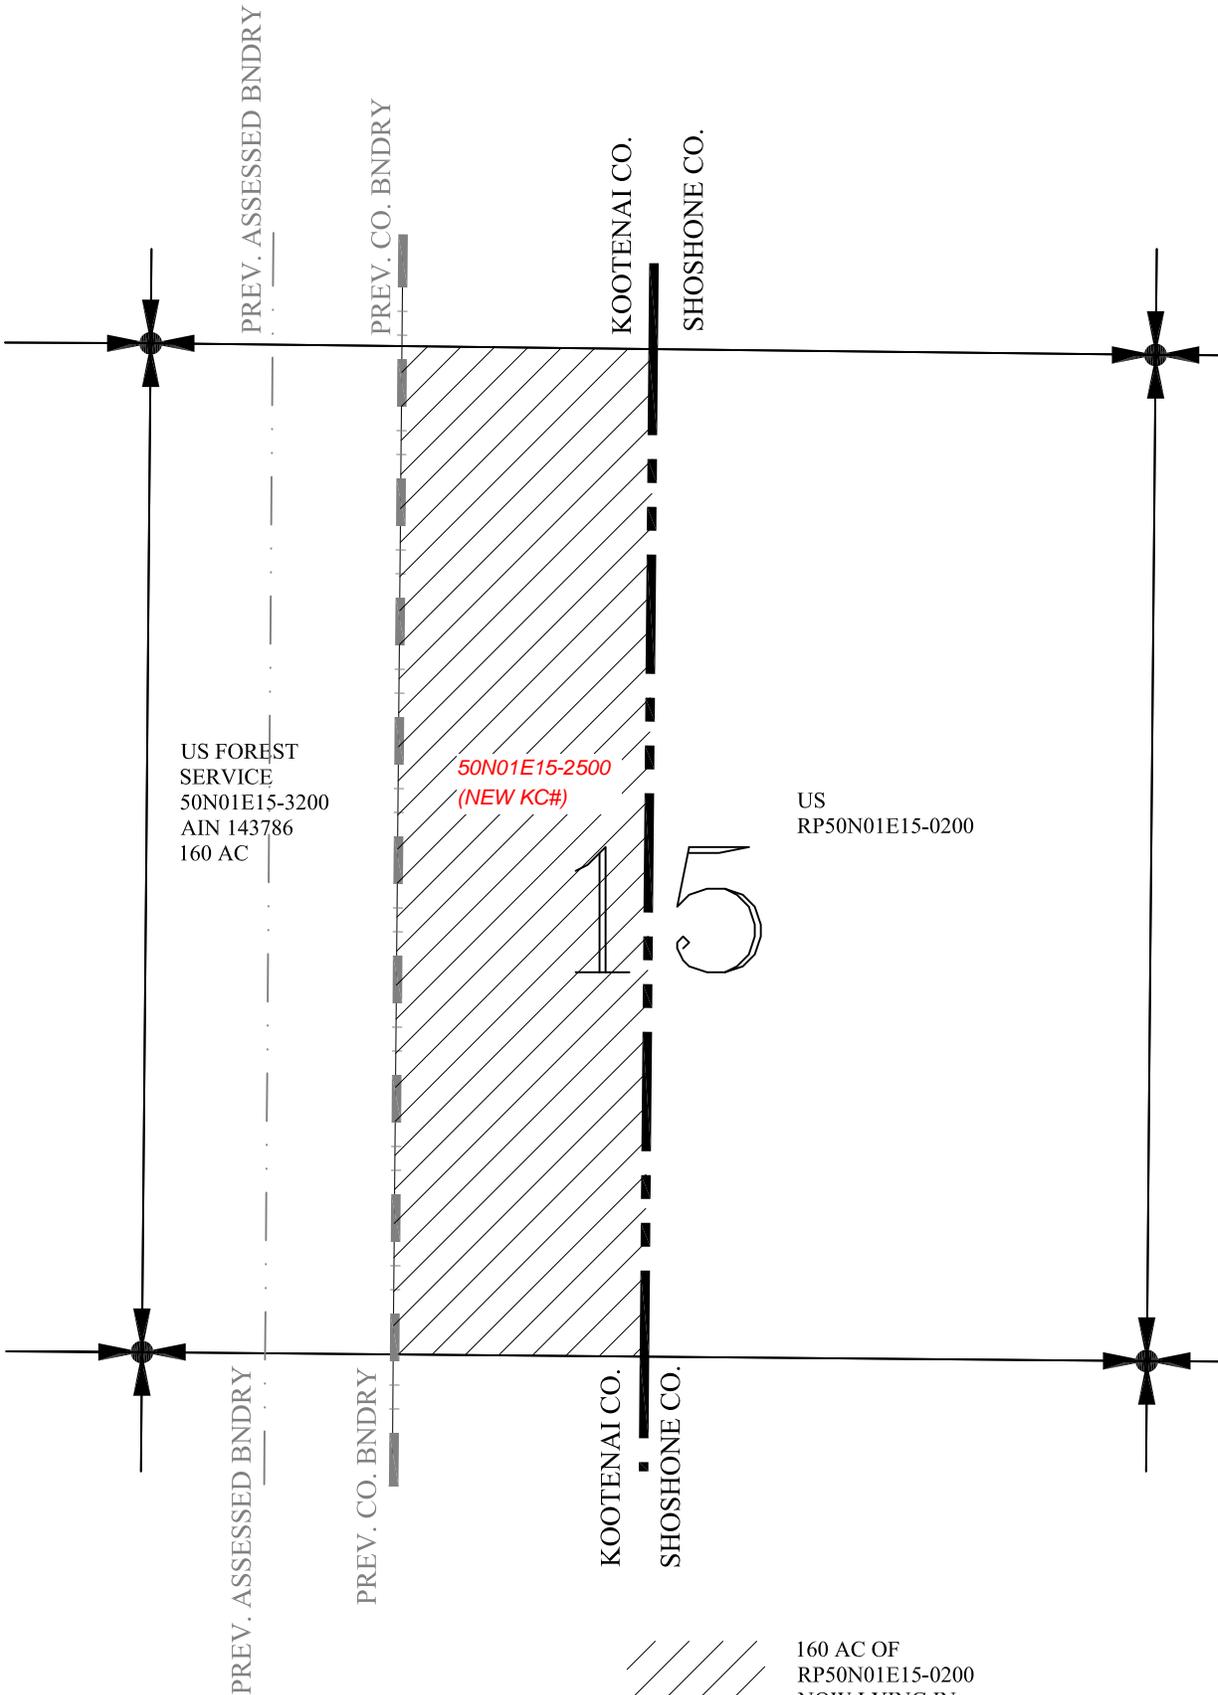

US FOREST SERVICE  
50N01E15-3200  
AIN 143786  
160 AC

50N01E15-2500  
(NEW KC#)

US  
RP50N01E15-0200

15

PREV. ASSESSED BNDRY

PREV. CO. BNDRY

KOOTENAI CO.

SHOSHONE CO.

PREV. ASSESSED BNDRY

PREV. CO. BNDRY

KOOTENAI CO.


SHOSHONE CO.



160 AC OF  
RP50N01E15-0200  
NOW LYING IN  
KOOTENAI CO.  
320 AC REMAINDER  
IN SHOSHONE

# SEC 15, T50N, R1E

1" = 1,000'

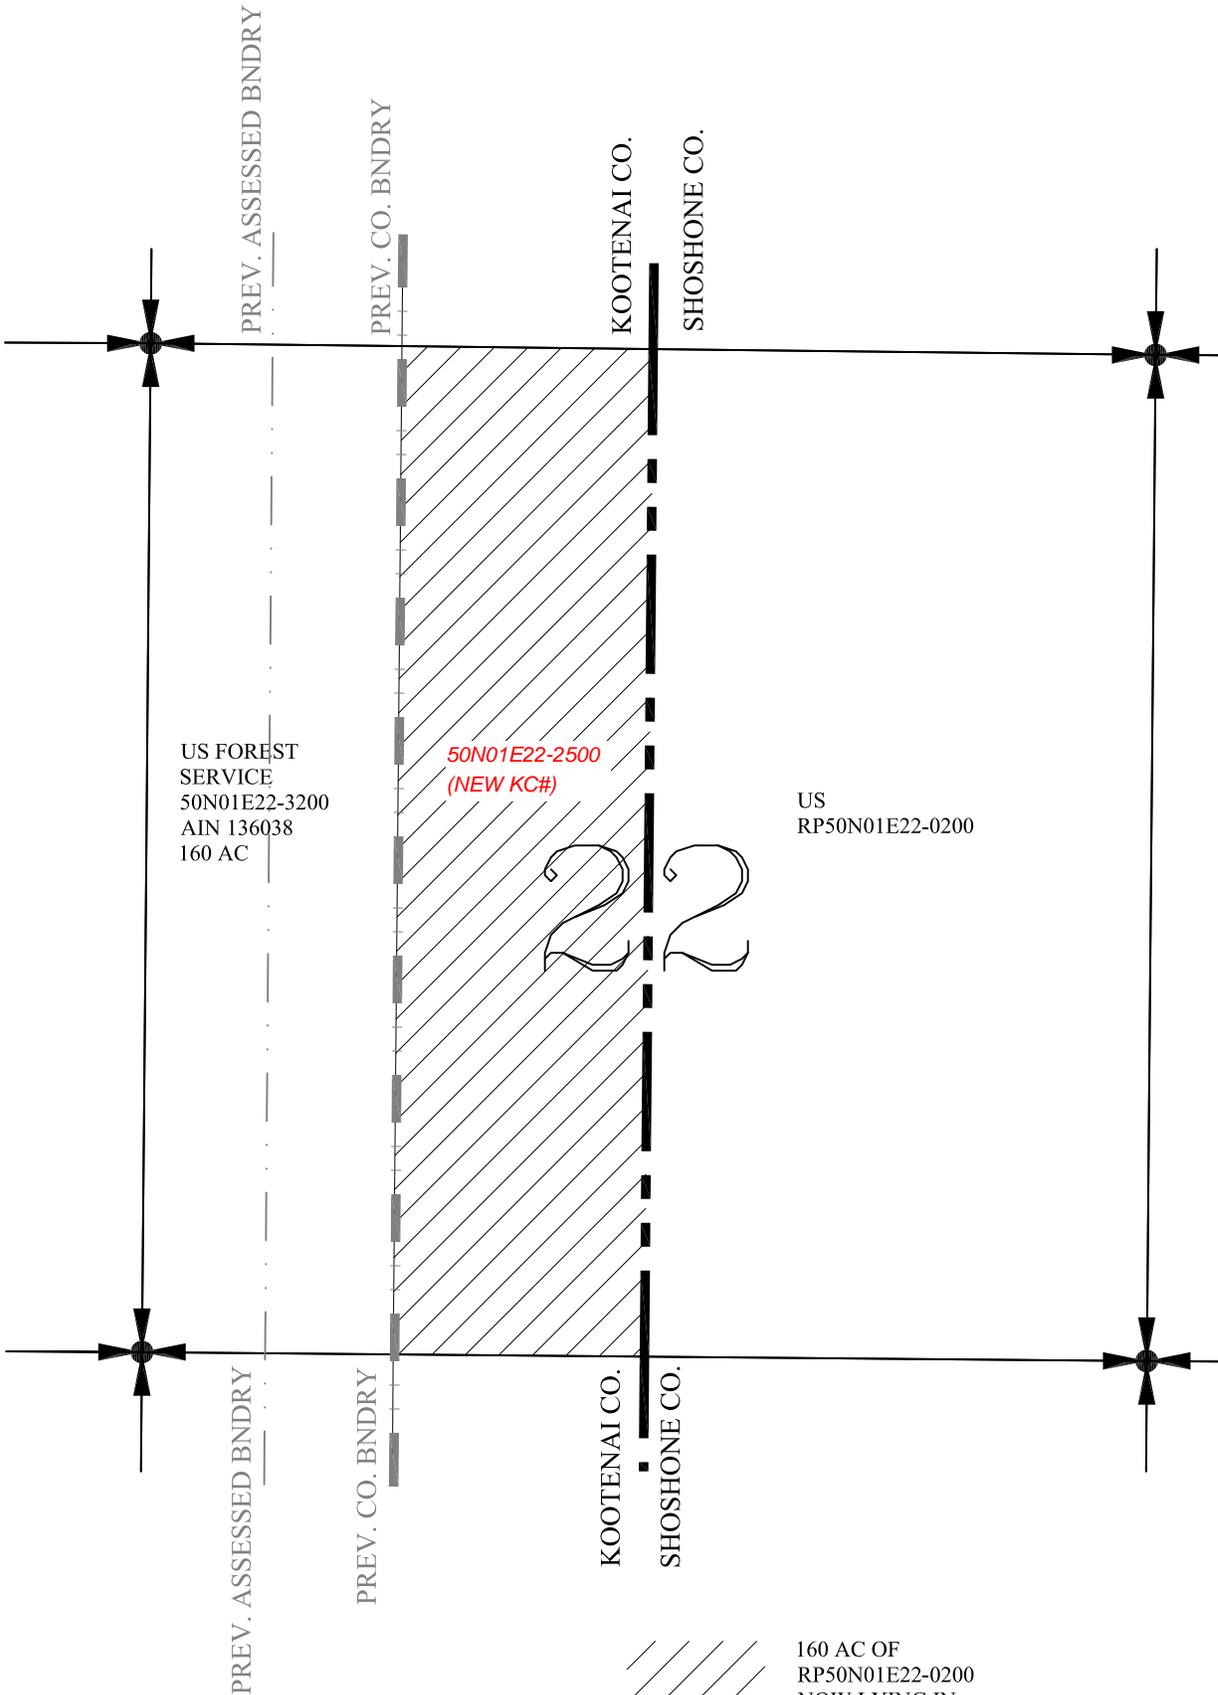

US FOREST SERVICE  
50N01E22-3200  
AIN 136038  
160 AC

50N01E22-2500  
(NEW KC#)

22

US  
RP50N01E22-0200

PREV. ASSESSED BNDRY

PREV. CO. BNDRY

KOOTENAI CO.

SHOSHONE CO.

PREV. ASSESSED BNDRY

PREV. CO. BNDRY

KOOTENAI CO.


SHOSHONE CO.



160 AC OF  
RP50N01E22-0200  
NOW LYING IN  
KOOTENAI CO.  
320 AC REMAINDER  
IN SHOSHONE

# SEC 22, T50N, R1E

1" = 1,000'

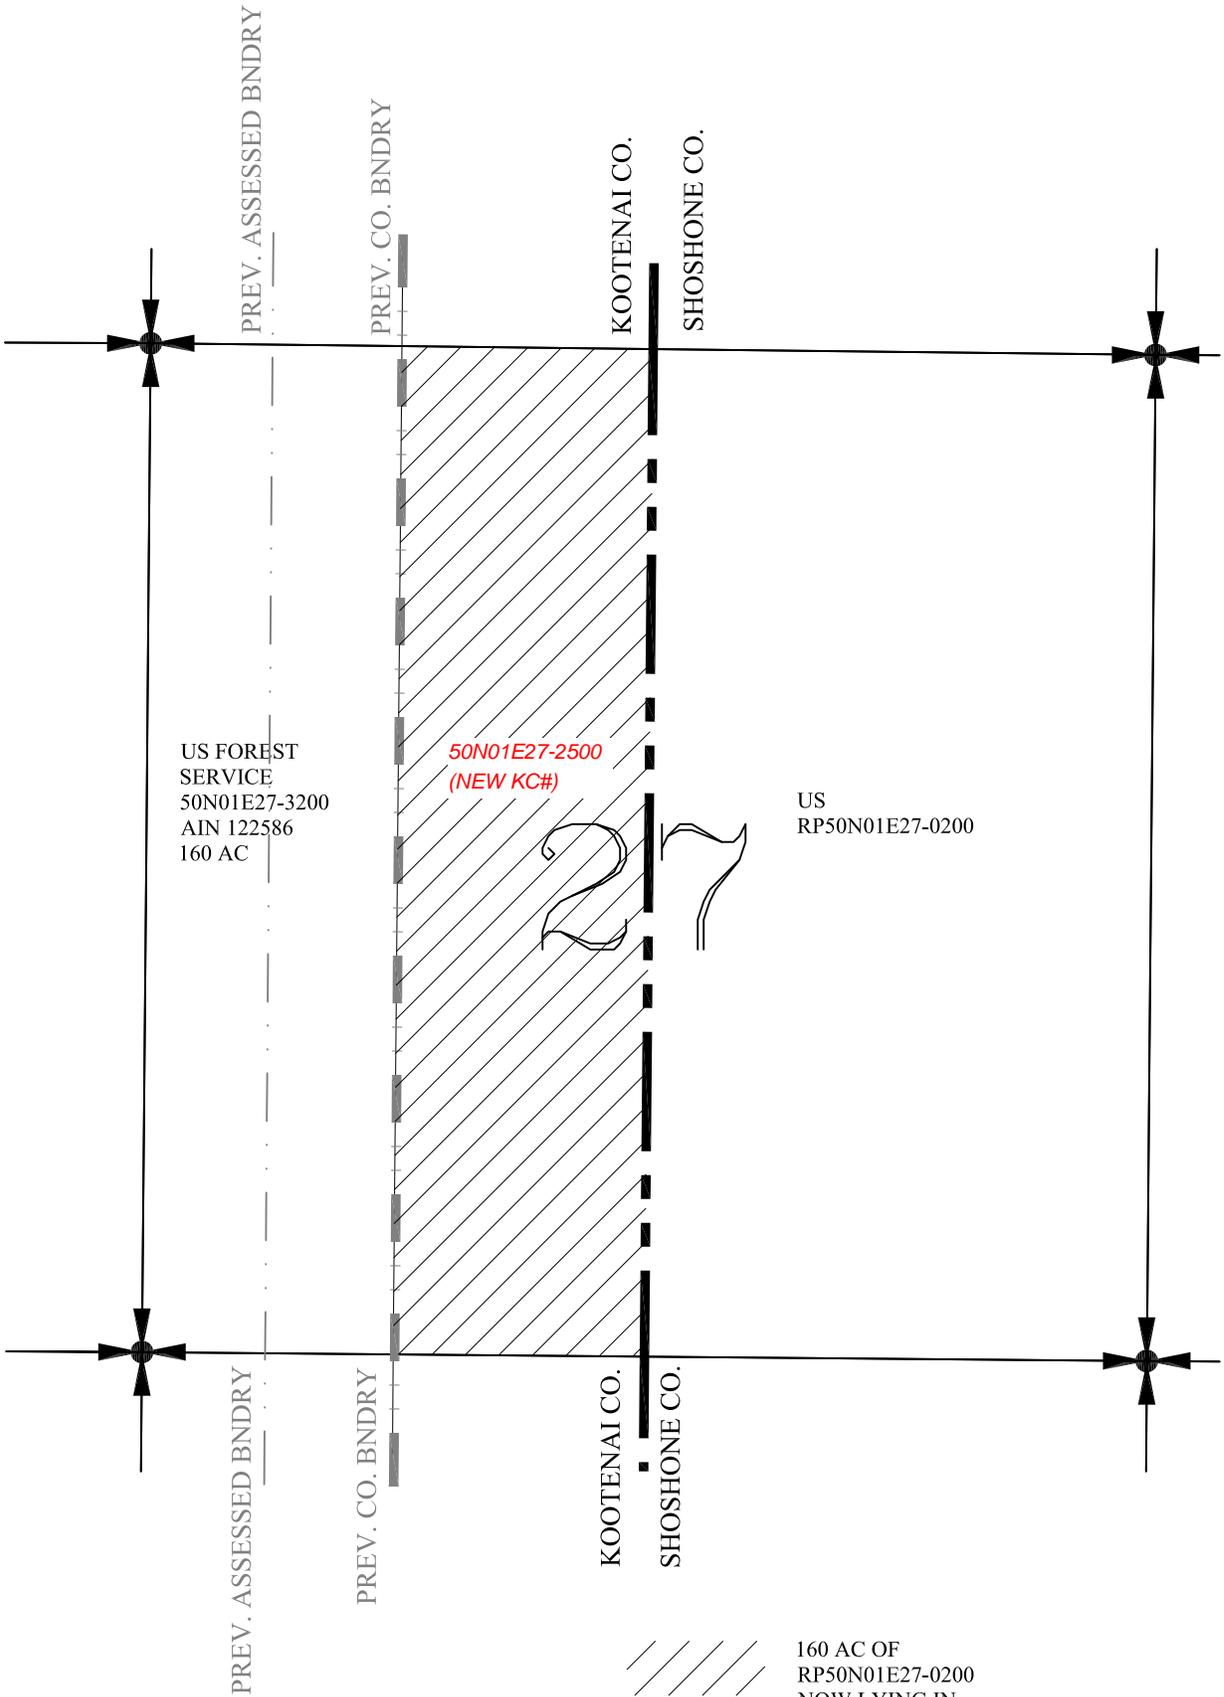

US FOREST SERVICE  
50N01E27-3200  
AIN 122586  
160 AC

50N01E27-2500  
(NEW KC#)

US  
RP50N01E27-0200

PREV. ASSESSED BNDRY

PREV. CO. BNDRY

KOOTENAI CO.

SHOSHONE CO.

PREV. ASSESSED BNDRY

PREV. CO. BNDRY

KOOTENAI CO.


SHOSHONE CO.



160 AC OF  
RP50N01E27-0200  
NOW LYING IN  
KOOTENAI CO.  
320 AC REMAINDER  
IN SHOSHONE

# SEC 27, T50N, R1E


1" = 1,000'

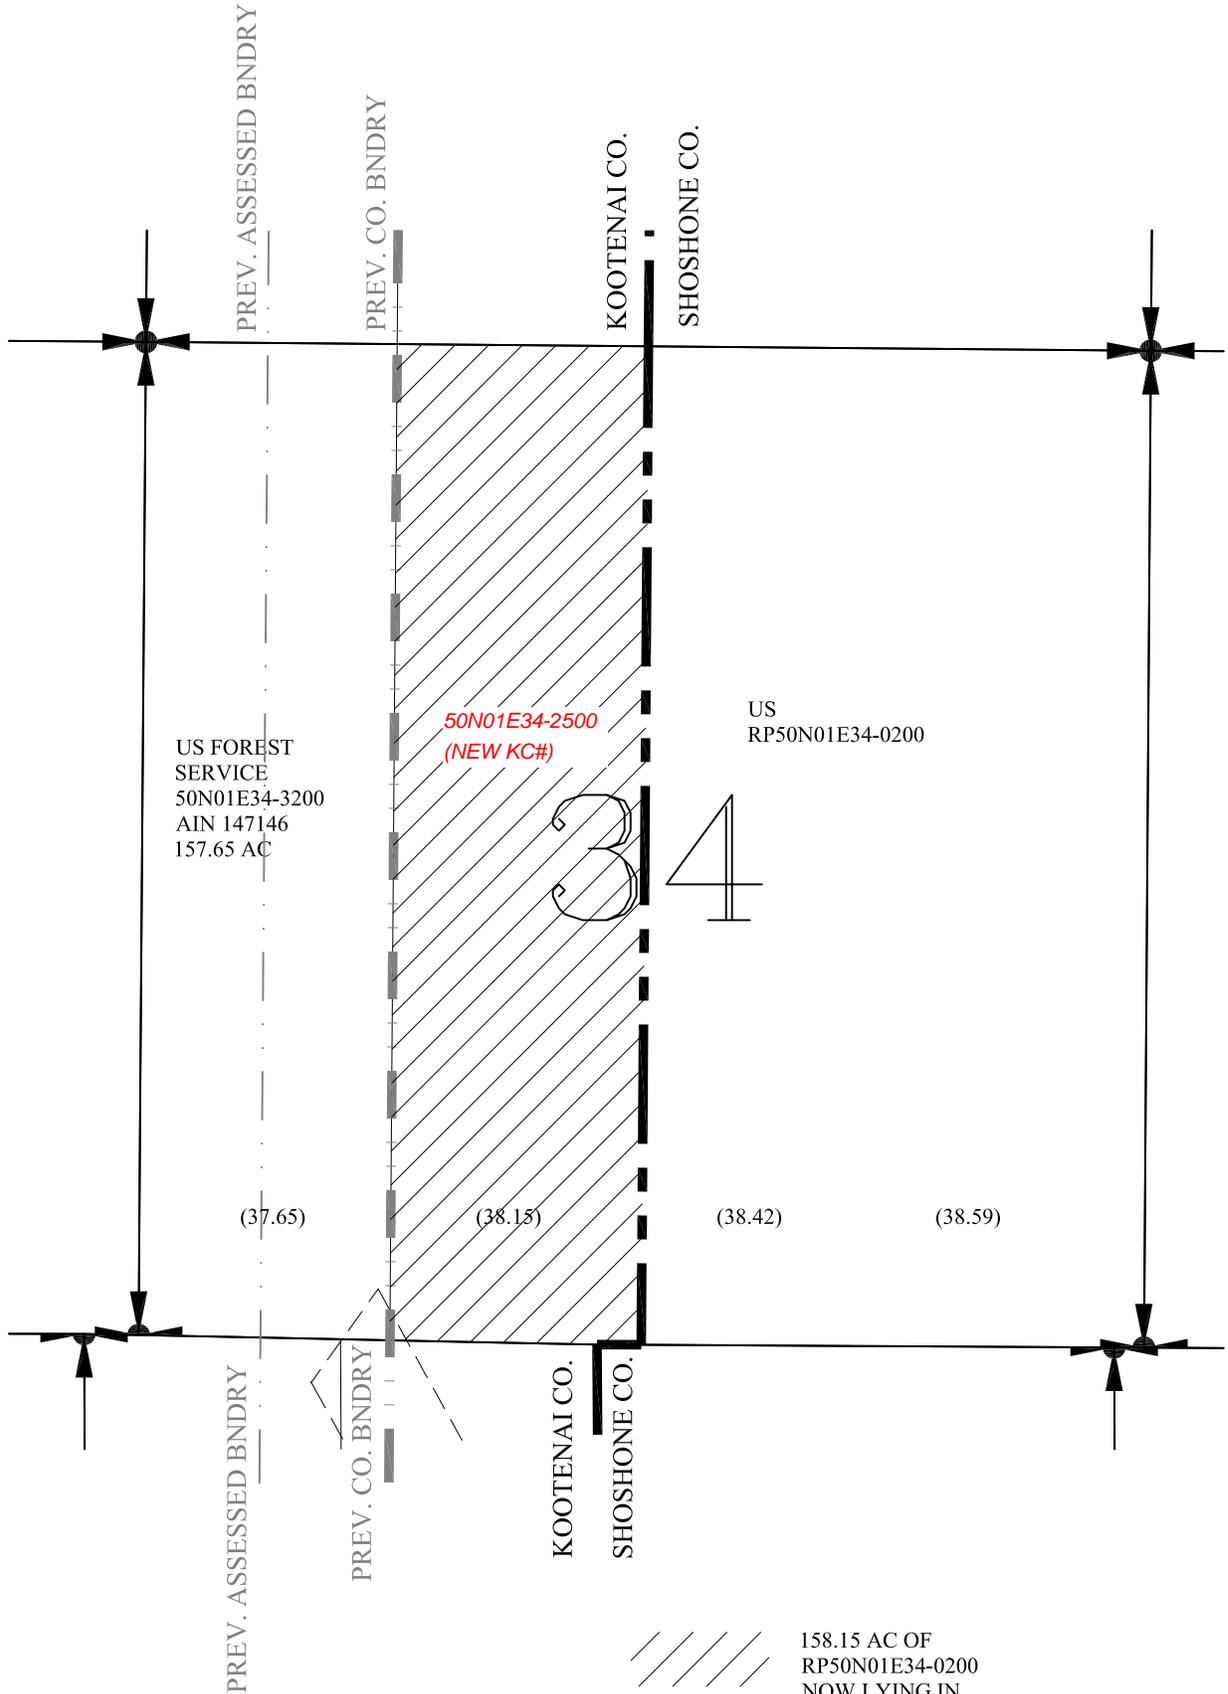

158.15 AC OF  
RP50N01E34-0200  
NOW LYING IN  
KOOTENAI CO.  
320 AC REMAINDER  
IN SHOSHONE

SEC 34, T50N, R1E

1" = 1,000'

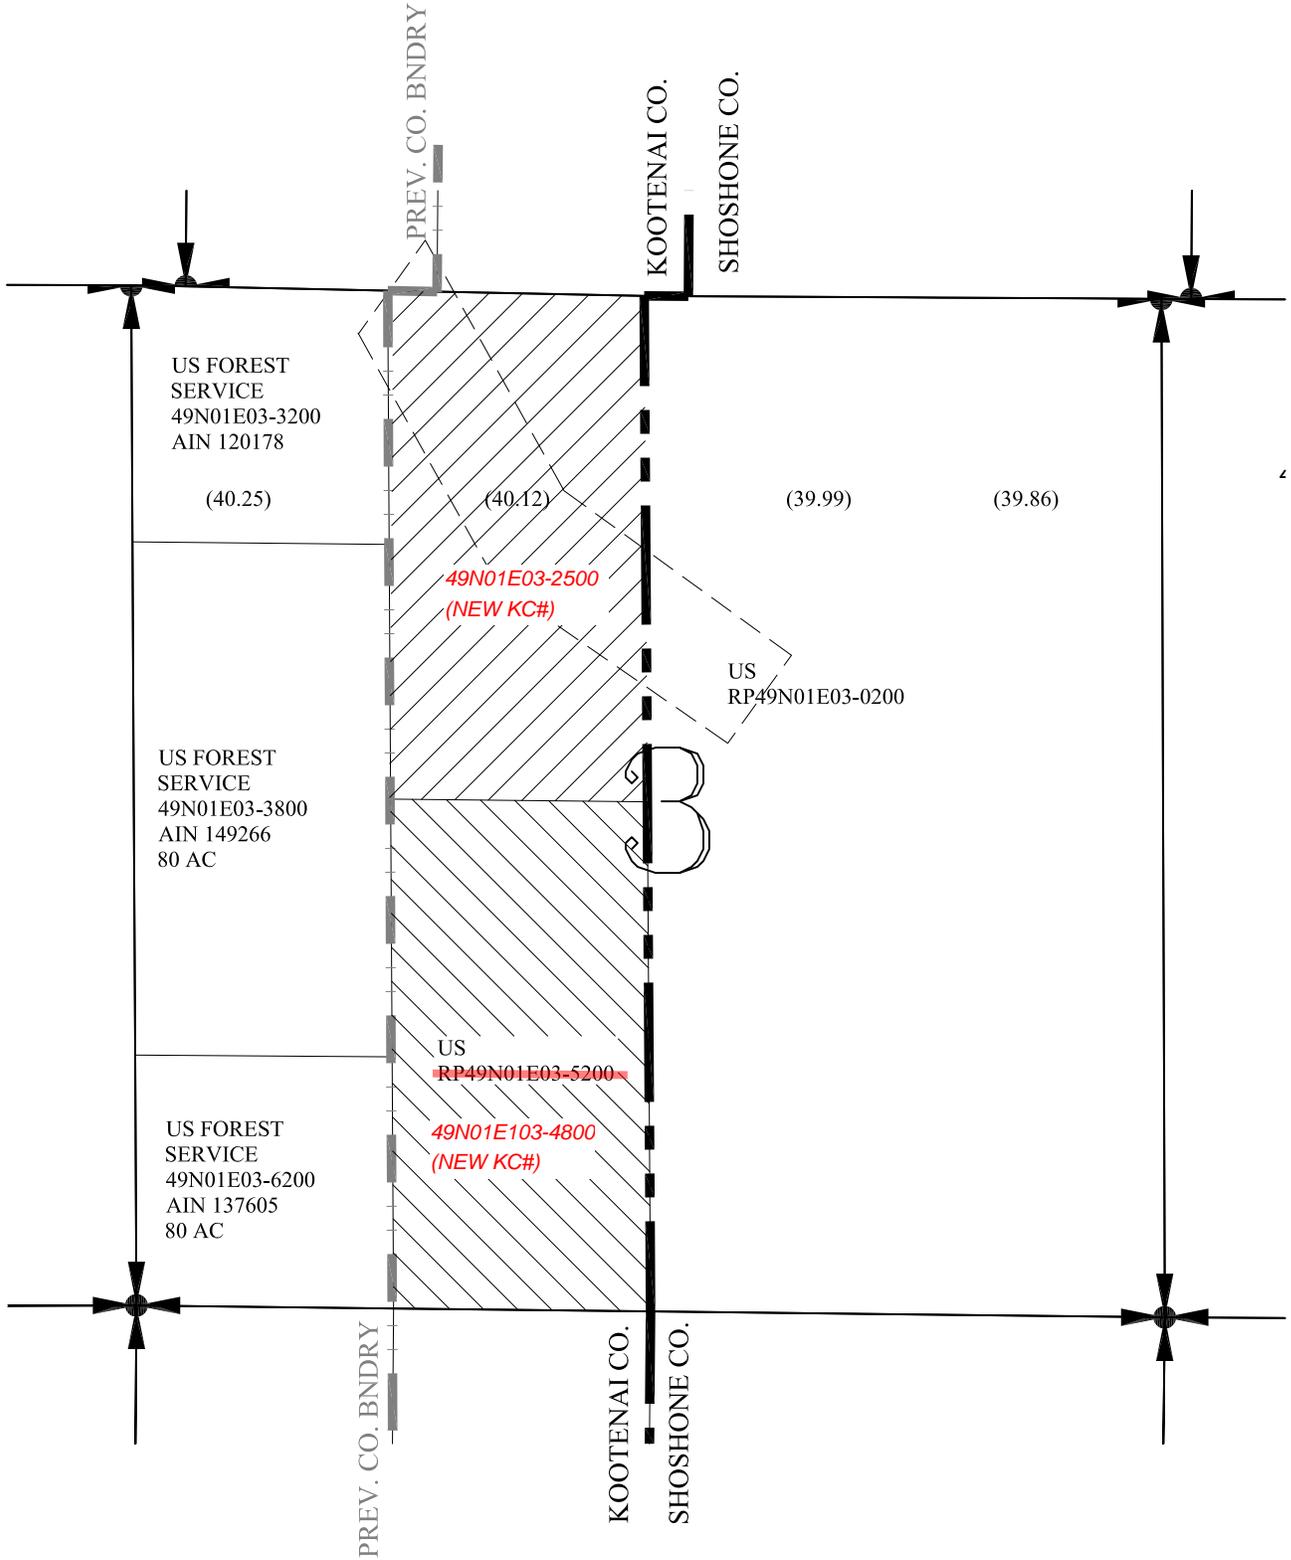


ALL OF RP49N01E03-5200  
NOW LYING IN  
KOOTENAI CO.



80.12 AC OF  
RP49N01E03-0200  
NOW LYING IN  
KOOTENAI CO.  
319.85 AC REMAINDER  
IN SHOSHONE

# SEC 03, T49N, R1E

1" = 1,000'

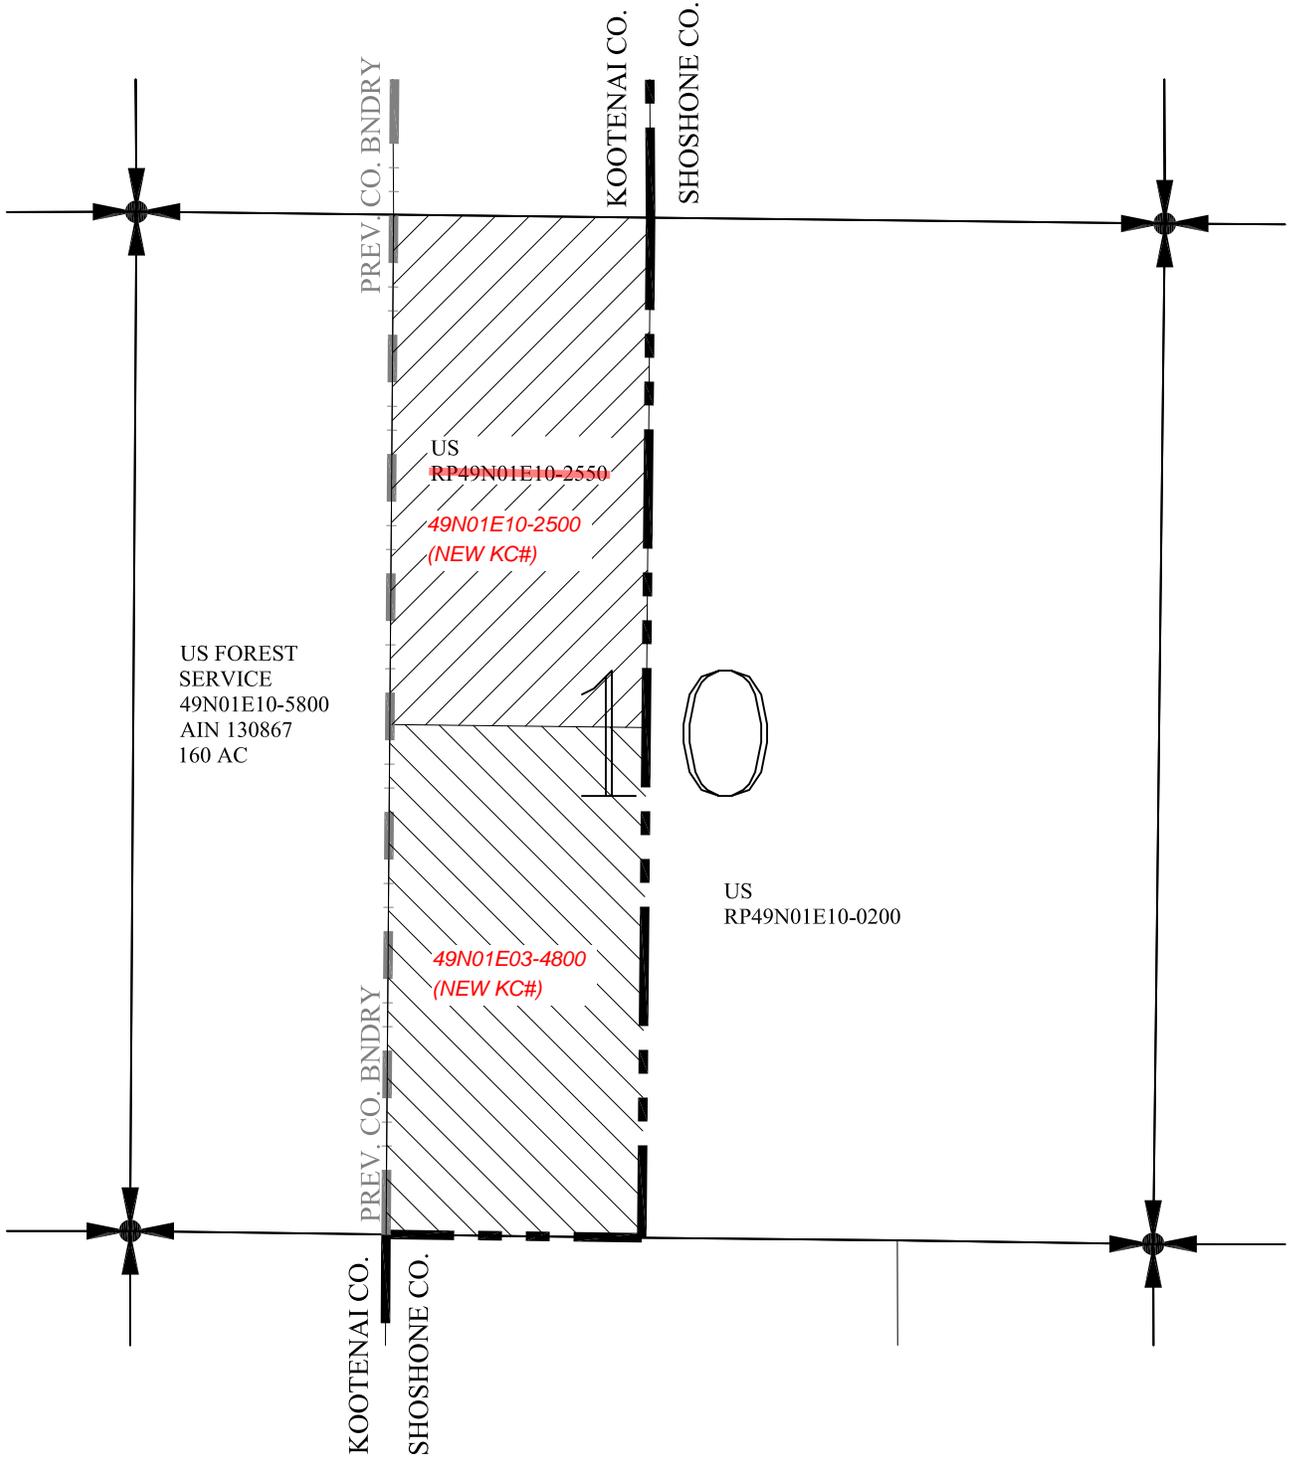

US FOREST SERVICE  
49N01E10-5800  
AIN 130867  
160 AC

US  
RP49N01E10-0200

49N01E03-4800  
(NEW KC#)




ALL OF RP49N01E10-2550  
NOW LYING IN  
KOOTENAI CO.



160 AC OF  
RP49N01E10-0200  
NOW LYING IN  
KOOTENAI CO.  
320 AC REMAINDER  
IN SHOSHONE

# SEC 10, T49N, R1E

1" = 1,000'

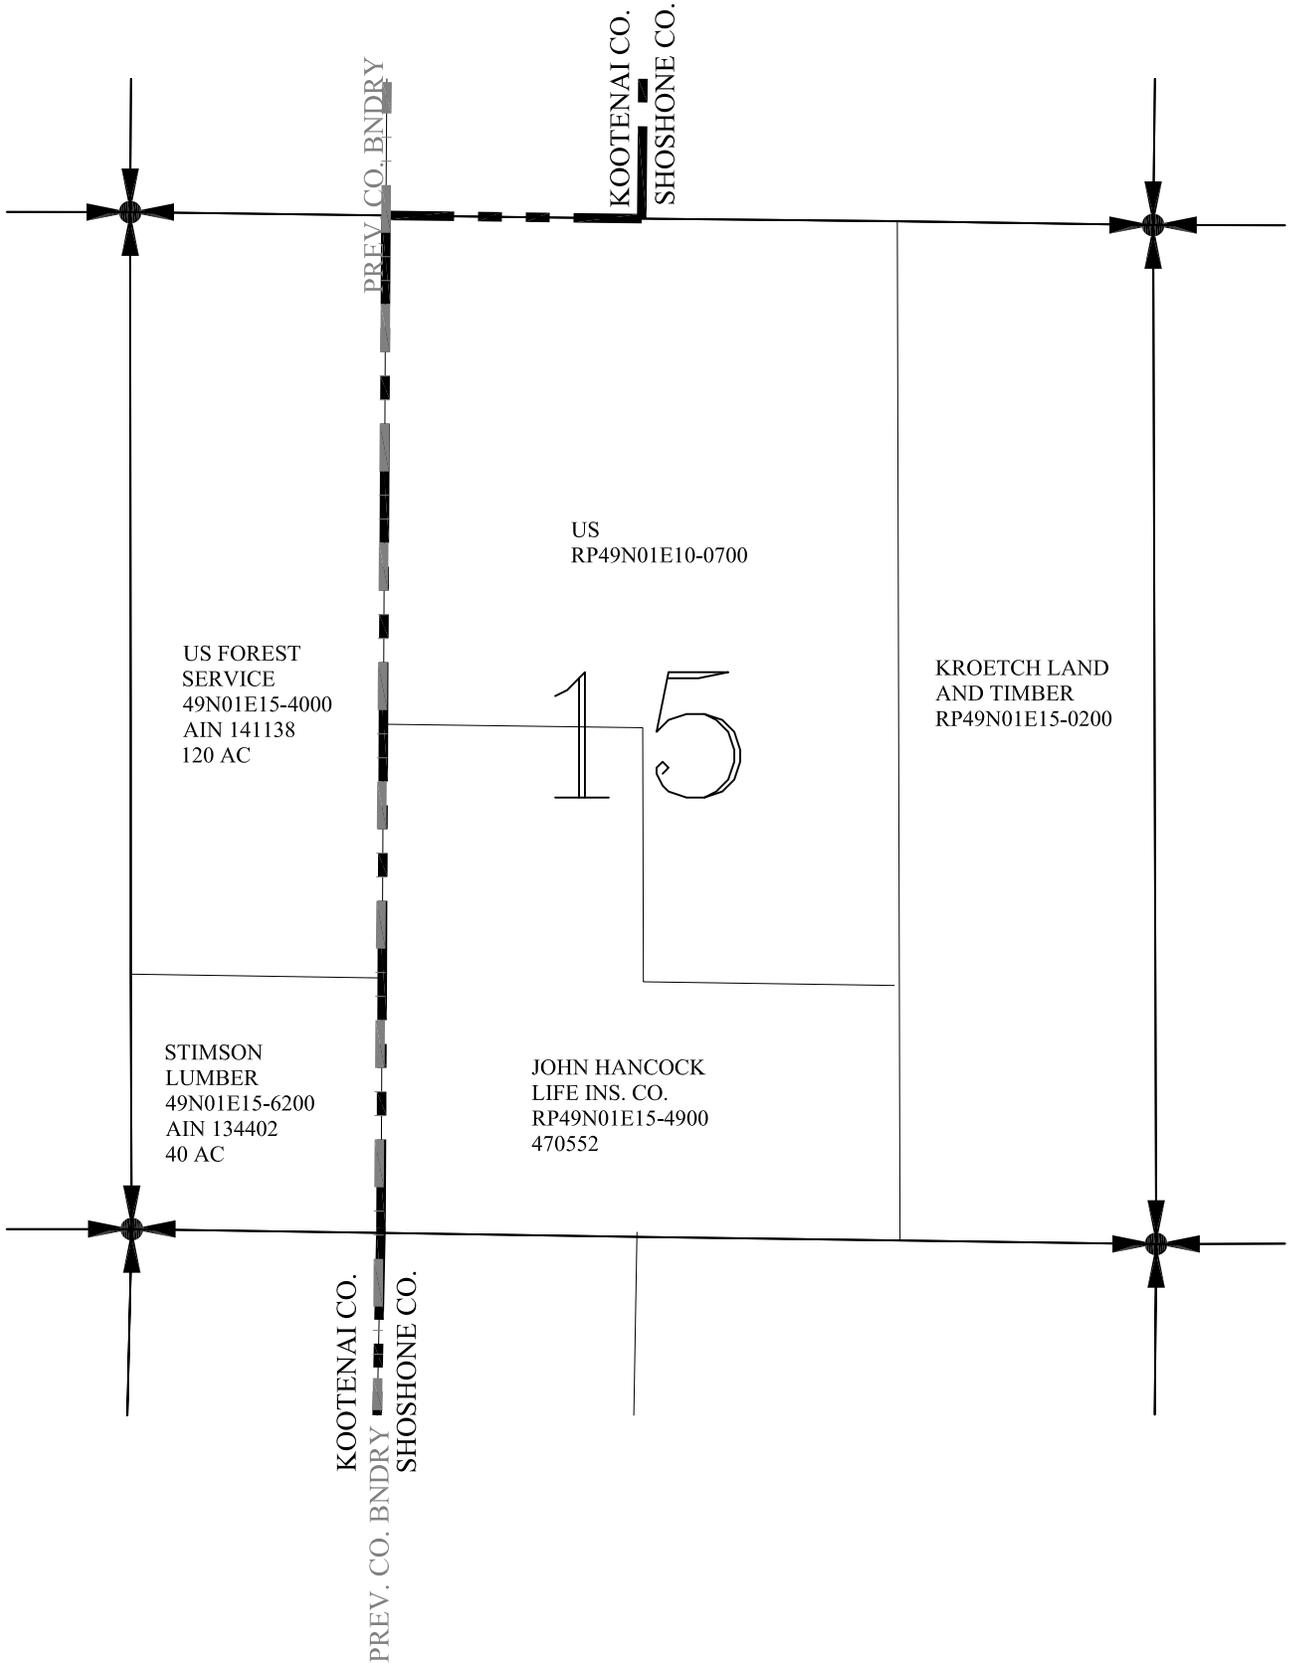

US FOREST SERVICE  
 49N01E15-4000  
 AIN 141138  
 120 AC

STIMSON LUMBER  
 49N01E15-6200  
 AIN 134402  
 40 AC

JOHN HANCOCK  
 LIFE INS. CO.  
 RP49N01E15-4900  
 470552

15

US  
 RP49N01E10-0700

KROETCH LAND  
 AND TIMBER  
 RP49N01E15-0200


PREV. CO. BNDRY

KOOTENAI CO.  
 SHOSHONE CO.

KOOTENAI CO.  
 PREV. CO. BNDRY  
 SHOSHONE CO.


SEC 15, T49N, R1E

1" = 1,000'

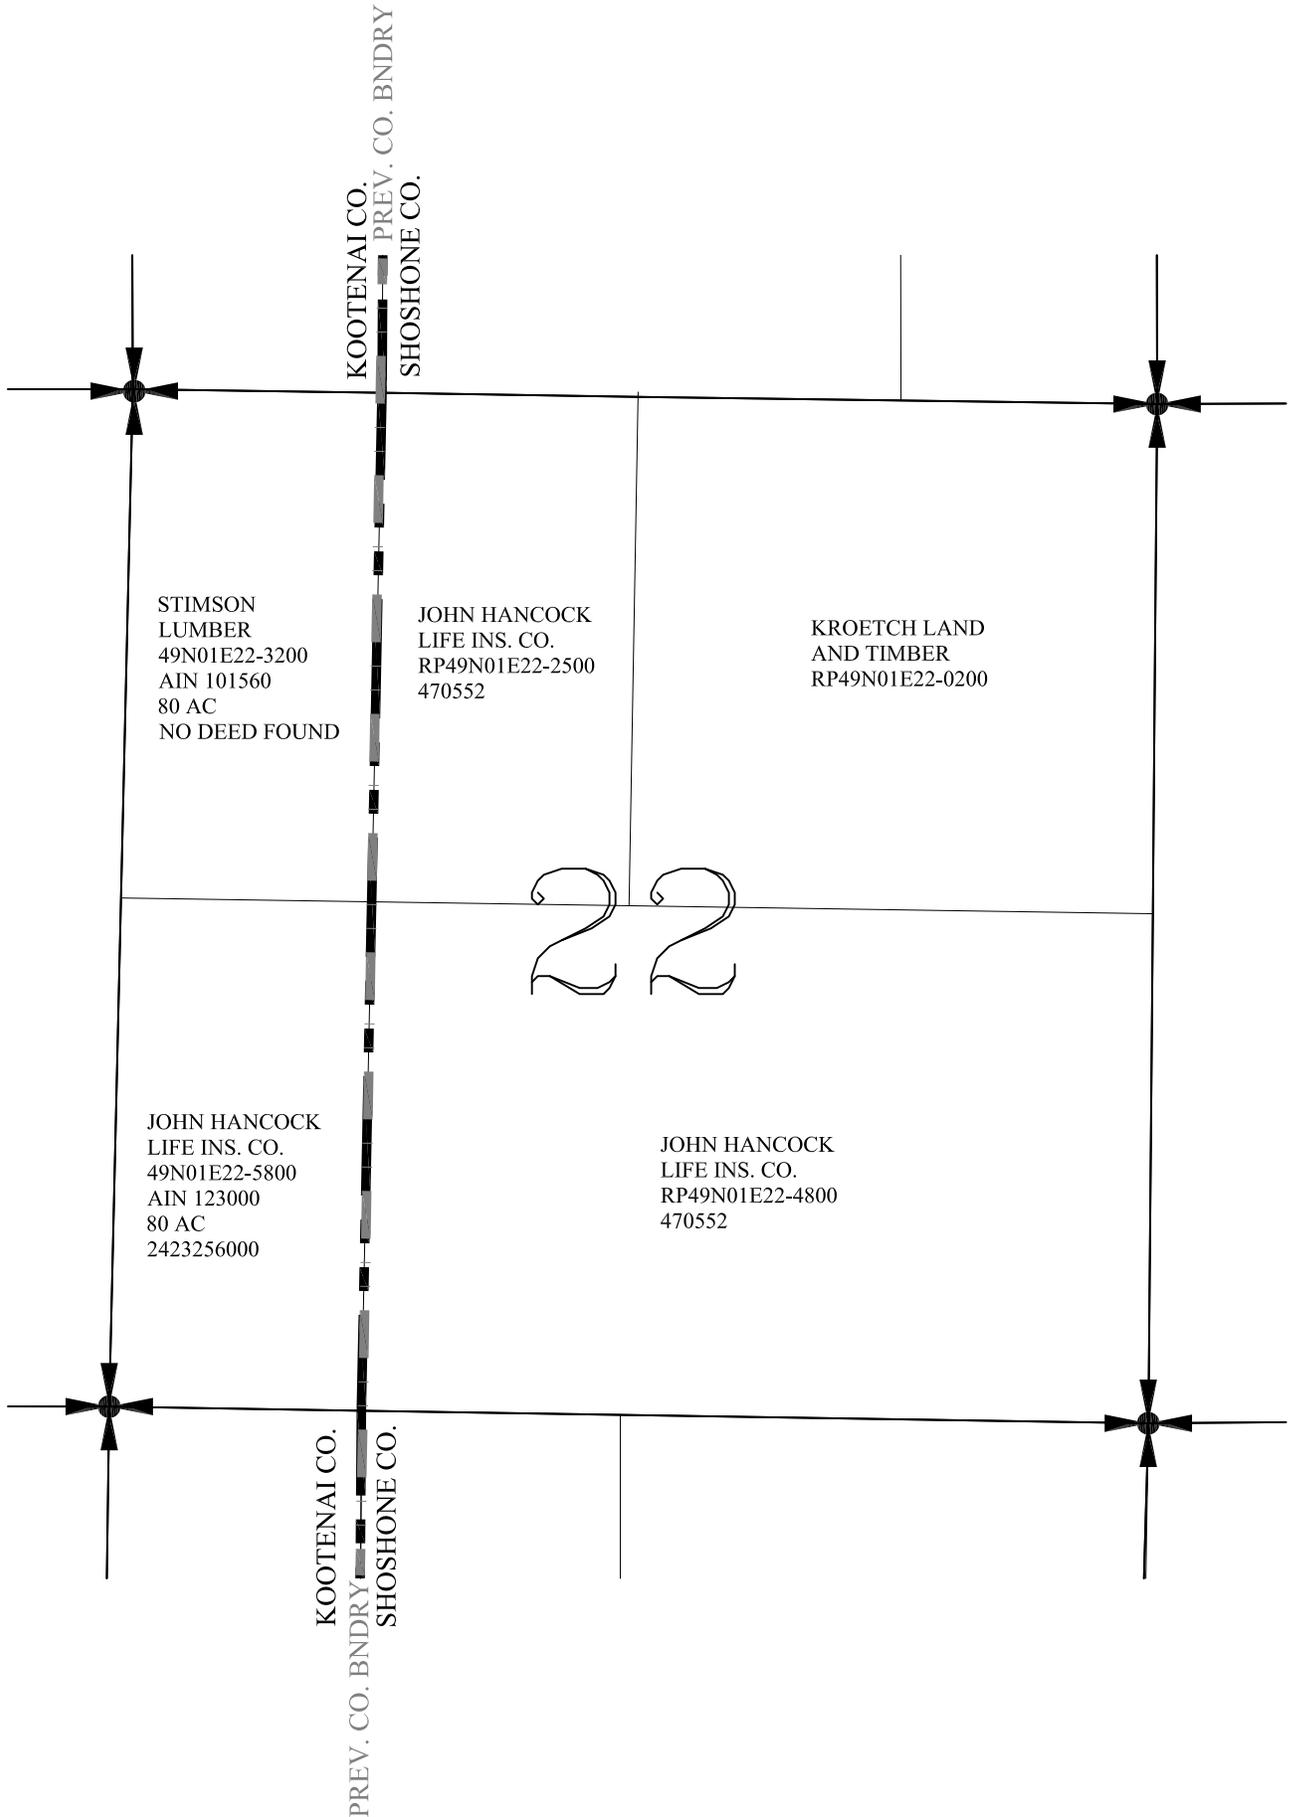


SEC 22, T49N, R1E

1" = 1,000'

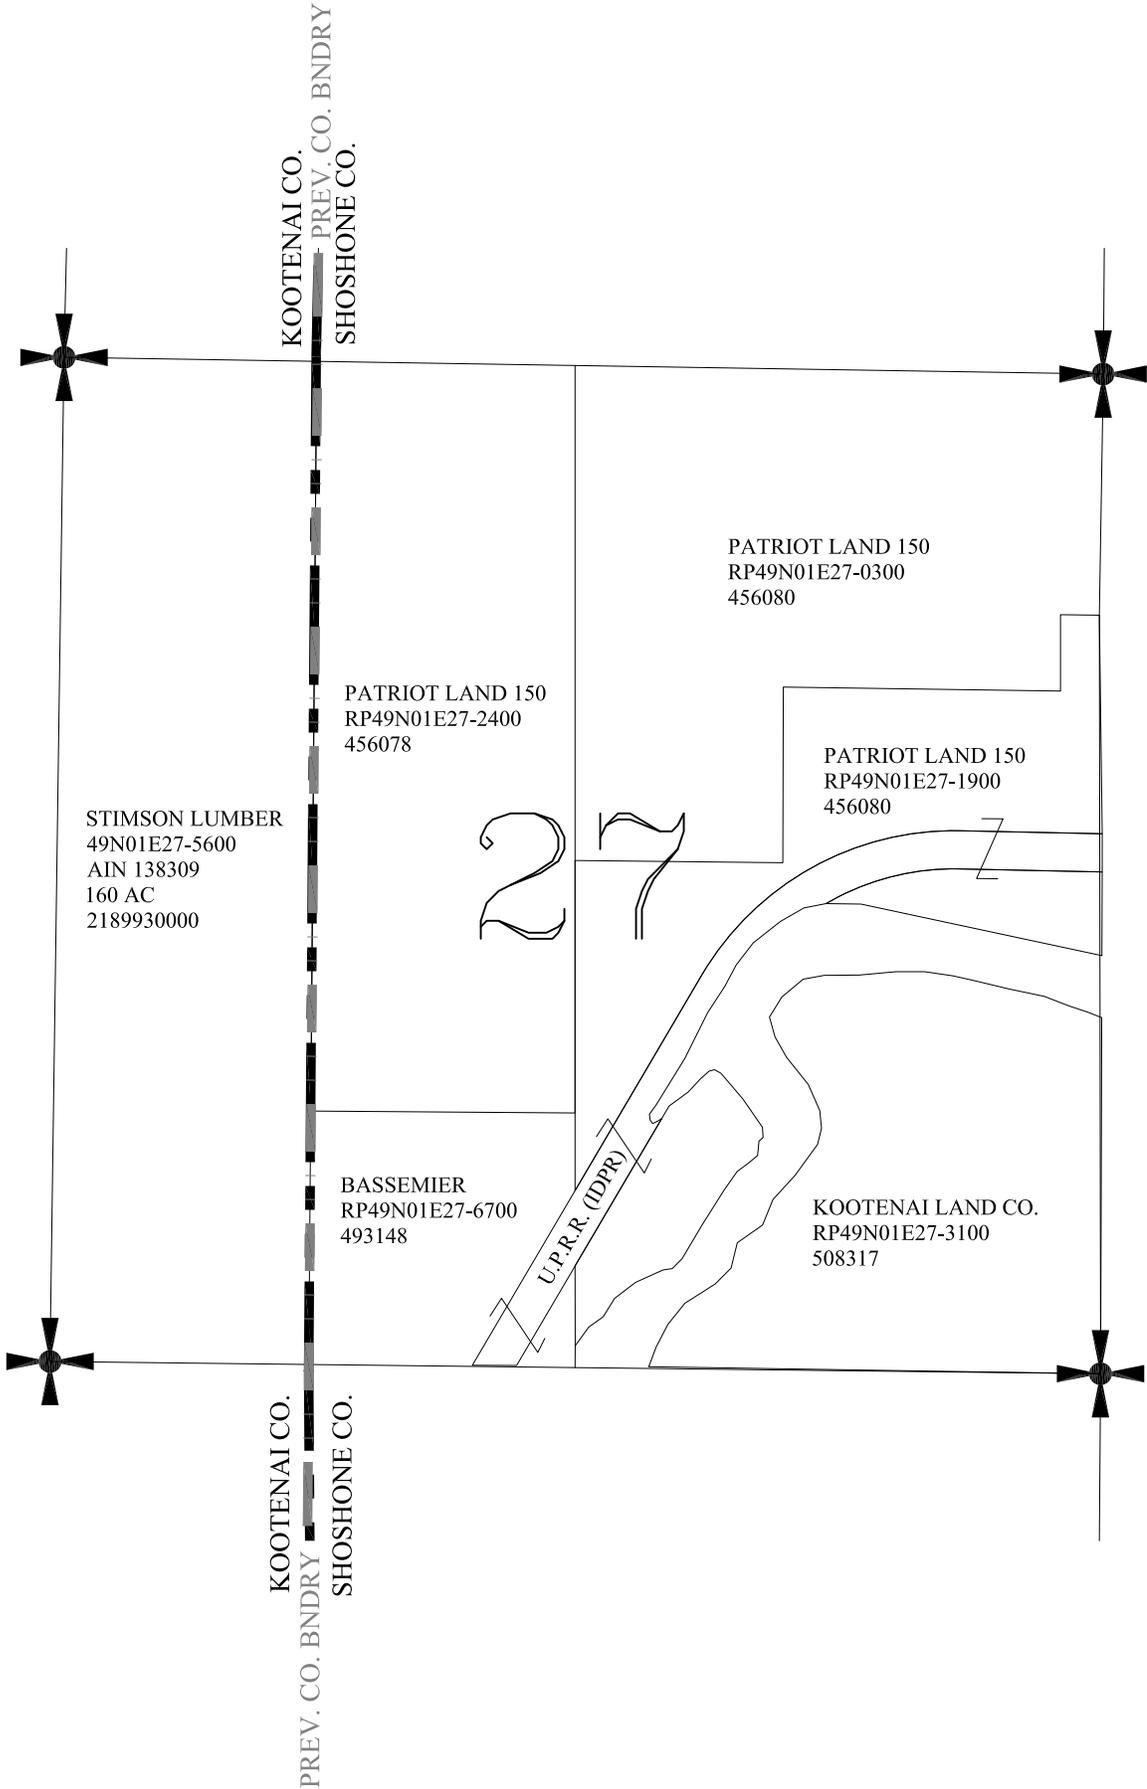

# SEC 27, T49N, R1E

1" = 500'

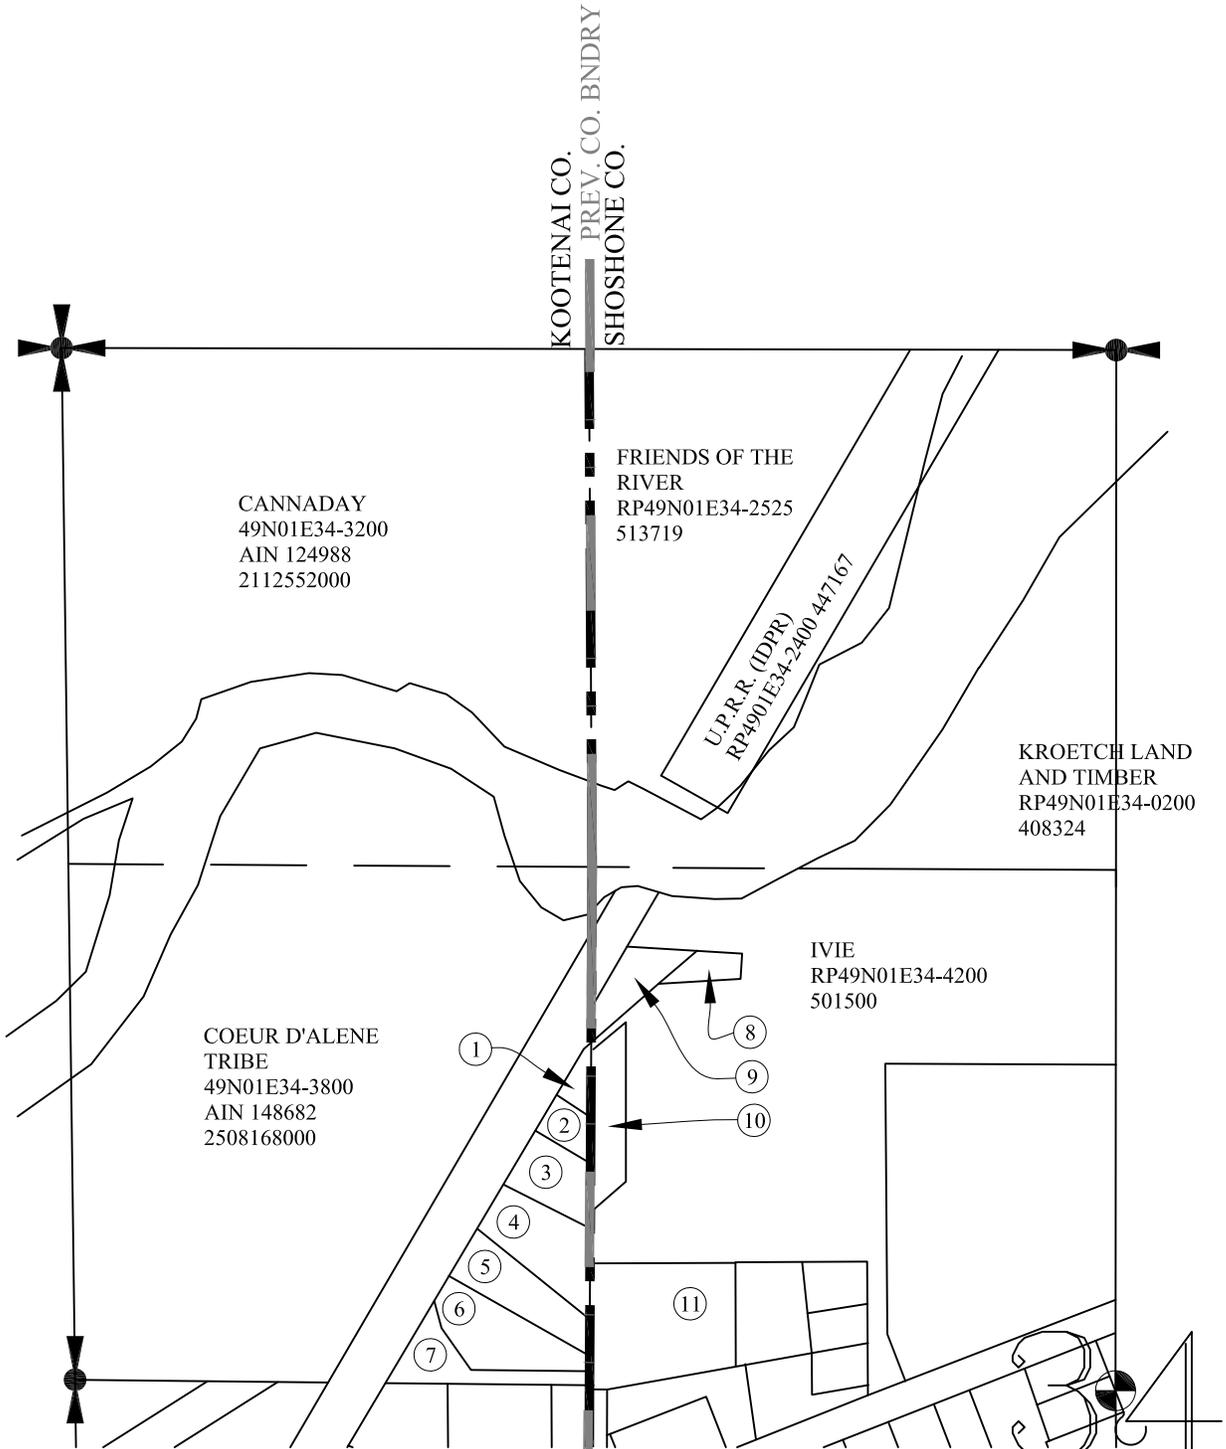


- ① KOOTENAI COUNTY  
49N01E34-3700  
AIN 132220
- ② HANSON  
49N01E34-3725  
AIN 118851  
2890364000
- ③ WALTER  
49N01E34-4075  
AIN 131853  
2473762000
- ④ WALTER  
49N01E34-4090  
AIN 148277  
2473762000

- ⑤ BLALACK  
49N01E34-4100  
AIN 133037  
2727320000
- ⑥ CLEMENS  
49N01E34-4125  
AIN 108823  
2154371000
- ⑦ KOOTENAI COUNTY  
49N01E34-4150  
AIN 106101

- ⑧ STANFORD  
RP49N01E34-4310  
491982
- ⑨ STANFORD  
RP49N01E34-4400  
491982
- ⑩ SHOSHONE COUNTY  
RP49N01E34-4450  
392884
- ⑪ TRECKER  
RP49N01E34-4600  
498914

# NW 1/4 SEC 34, T49N, R1E

1" = 500'

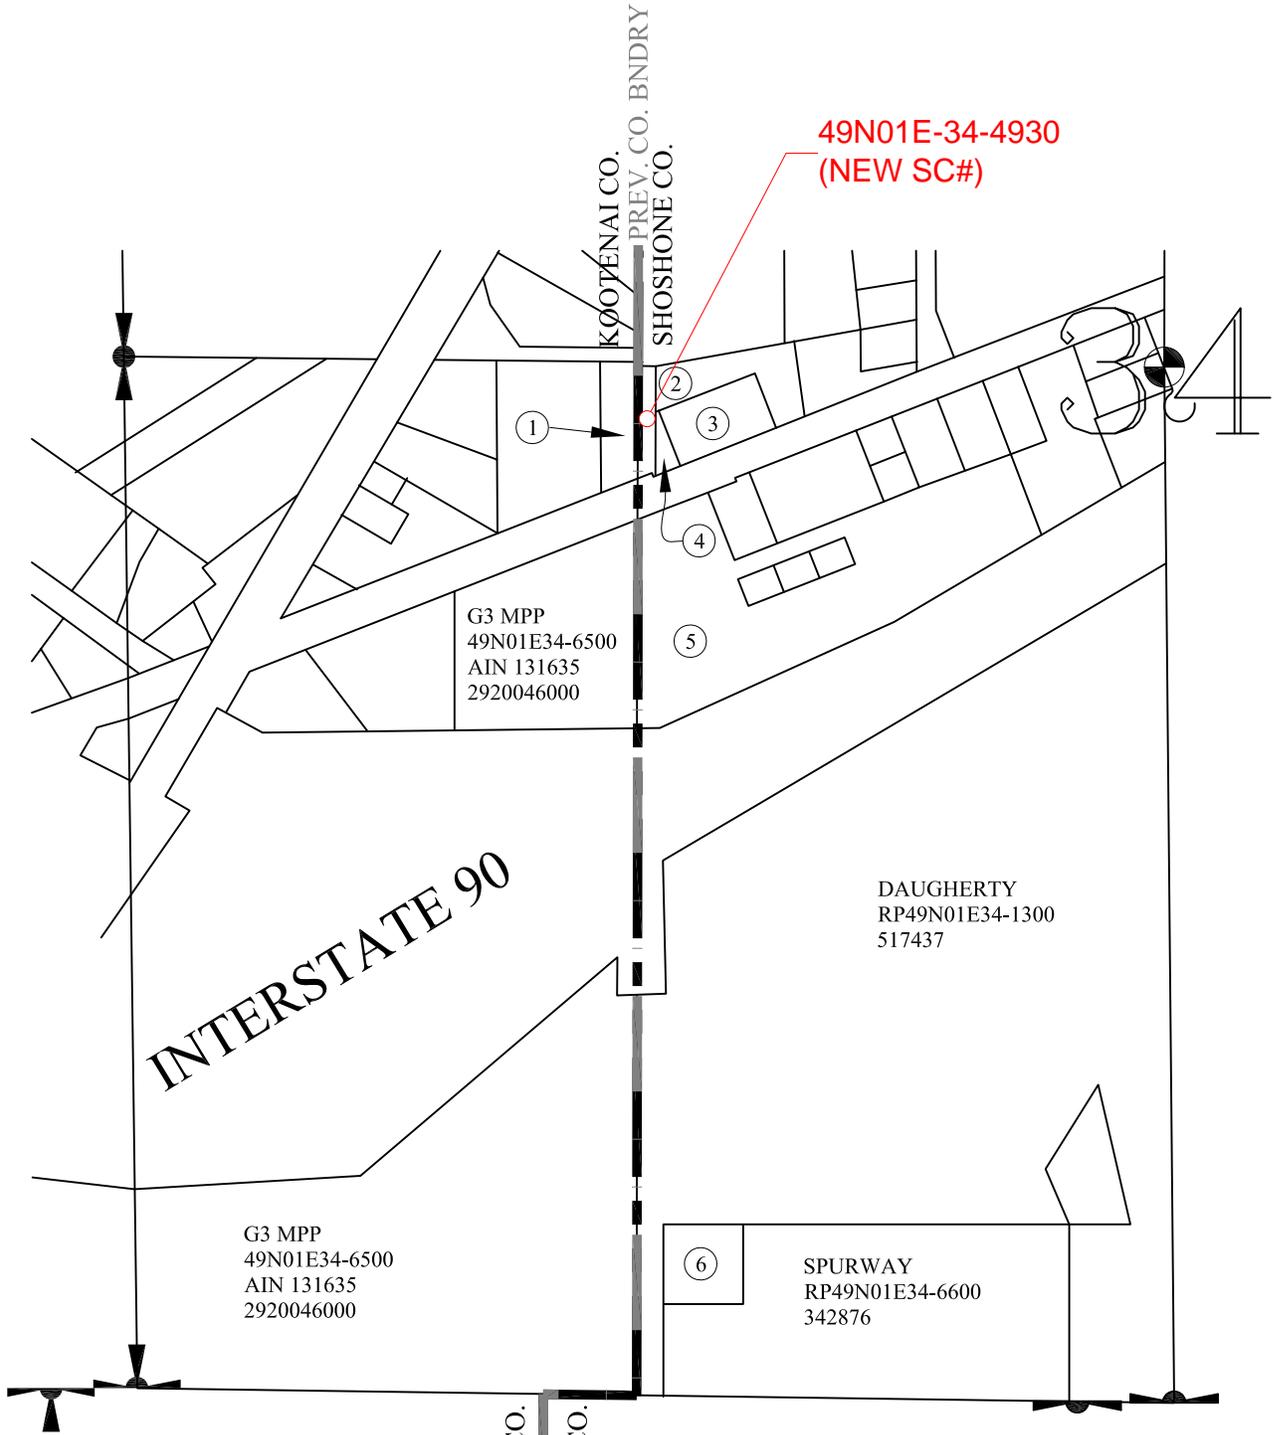

49N01E-34-4930  
(NEW SC#)

G3 MPP  
49N01E34-6500  
AIN 131635  
2920046000

DAUGHERTY  
RP49N01E34-1300  
517437

G3 MPP  
49N01E34-6500  
AIN 131635  
2920046000

SPURWAY  
RP49N01E34-6600  
342876

- ① KOOTENAI COUNTY  
49N01E34-5420  
AIN 142637  
PARTIALLY IN  
SHOSHONE
- ② CRAIN  
RPO11900010010  
493368
- ③ GILBERT  
RP49N01E34-4910  
510367

- ④ ISHAM  
RP49N01E34-4920  
494829
- ⑤ DAUGHERTY  
RP49N01E34-1325  
517437
- ⑥ LANNEN LIVING  
TRUST  
RP49N01E34-6400  
470401


KOOTENAI CO.  
PREV. CO. BNDRY  
SHOSHONE CO.

SW 1/4 SEC 34, T49N, R1E

1" = 1,000'




- ① ANDERSON  
RP48N01E03-2550  
414112
- ② ANDERSON  
RP48N01E03-2400  
414112
- ③ WILBUR  
RP48N01E03-2450  
484912
- ④ ALF  
RP48N01E03-2600  
459298
- ⑤ ACCURISO  
48N01E03-4500  
AIN 153192  
2722284000
- ⑥ ANDERSON  
RP48N01E03-4500  
501641

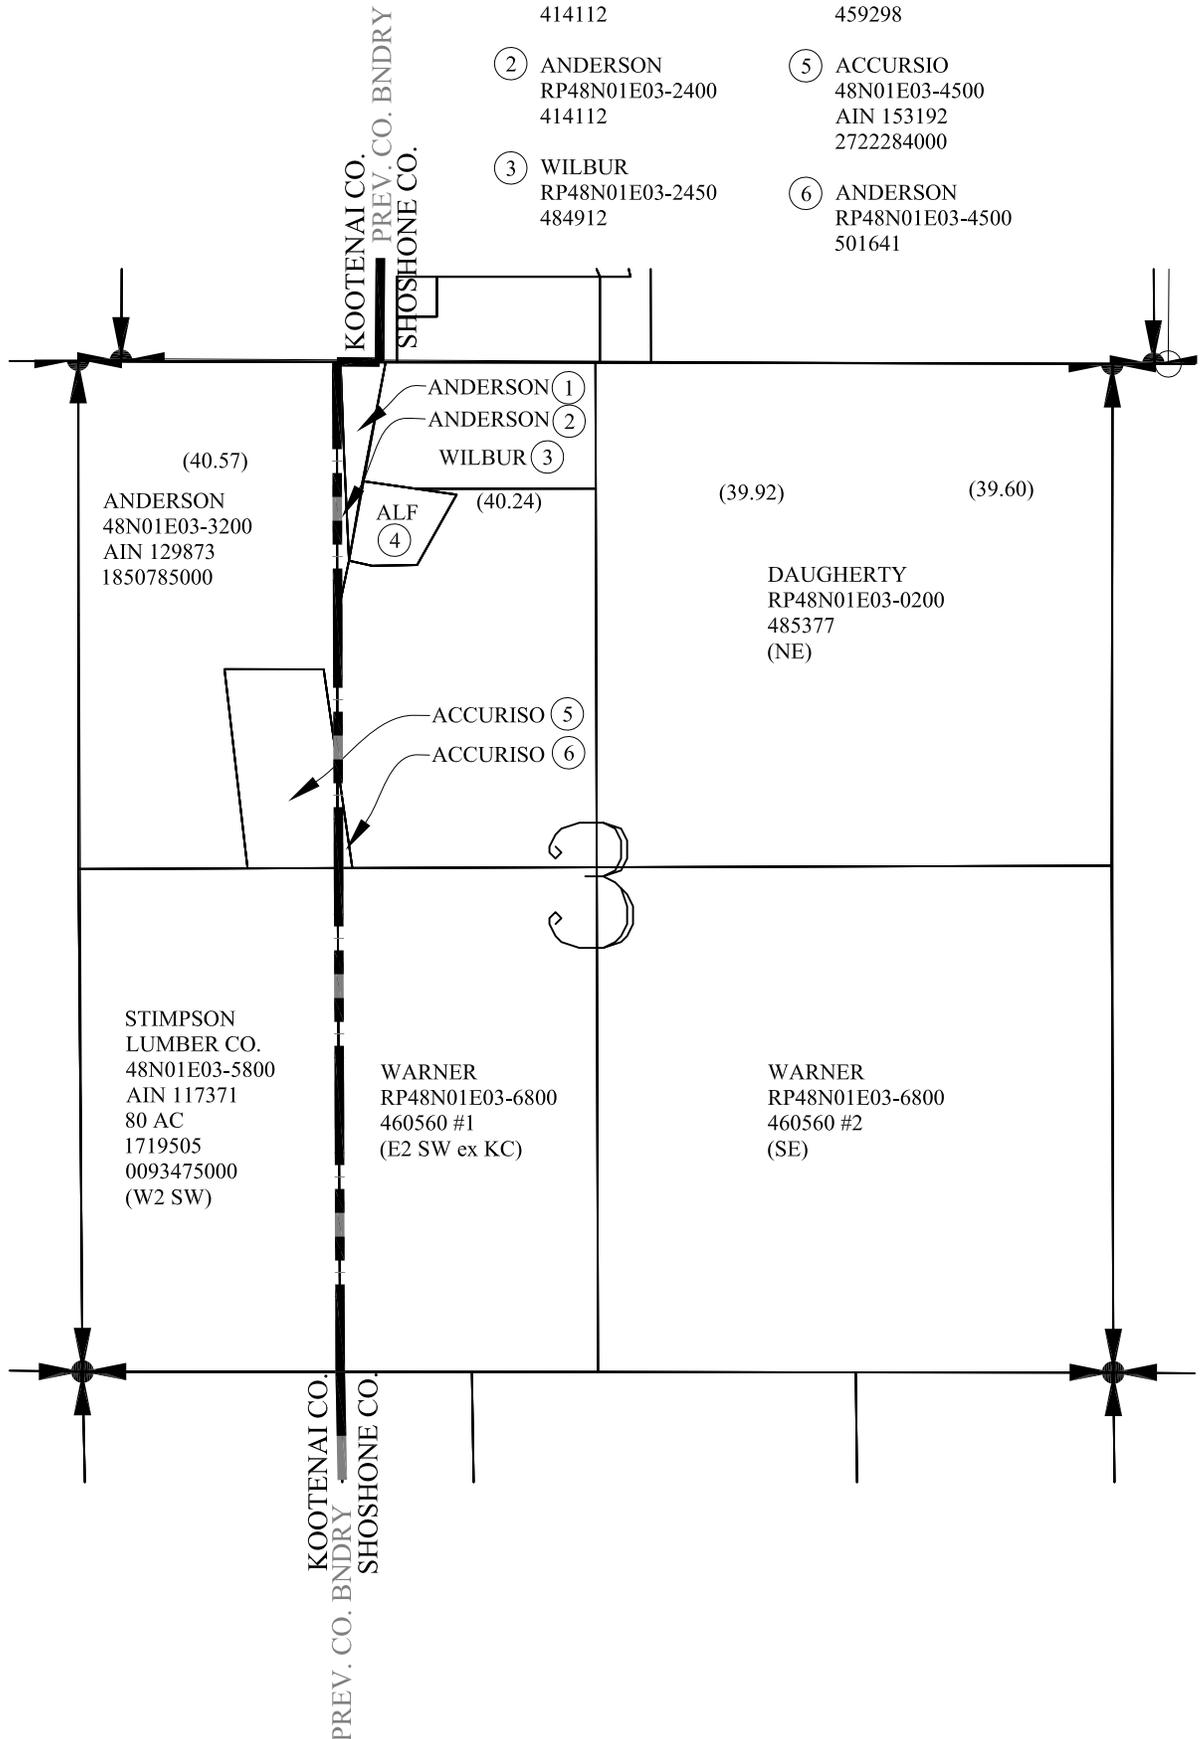


# SEC 03, T48N, R1E

1" = 1,000'

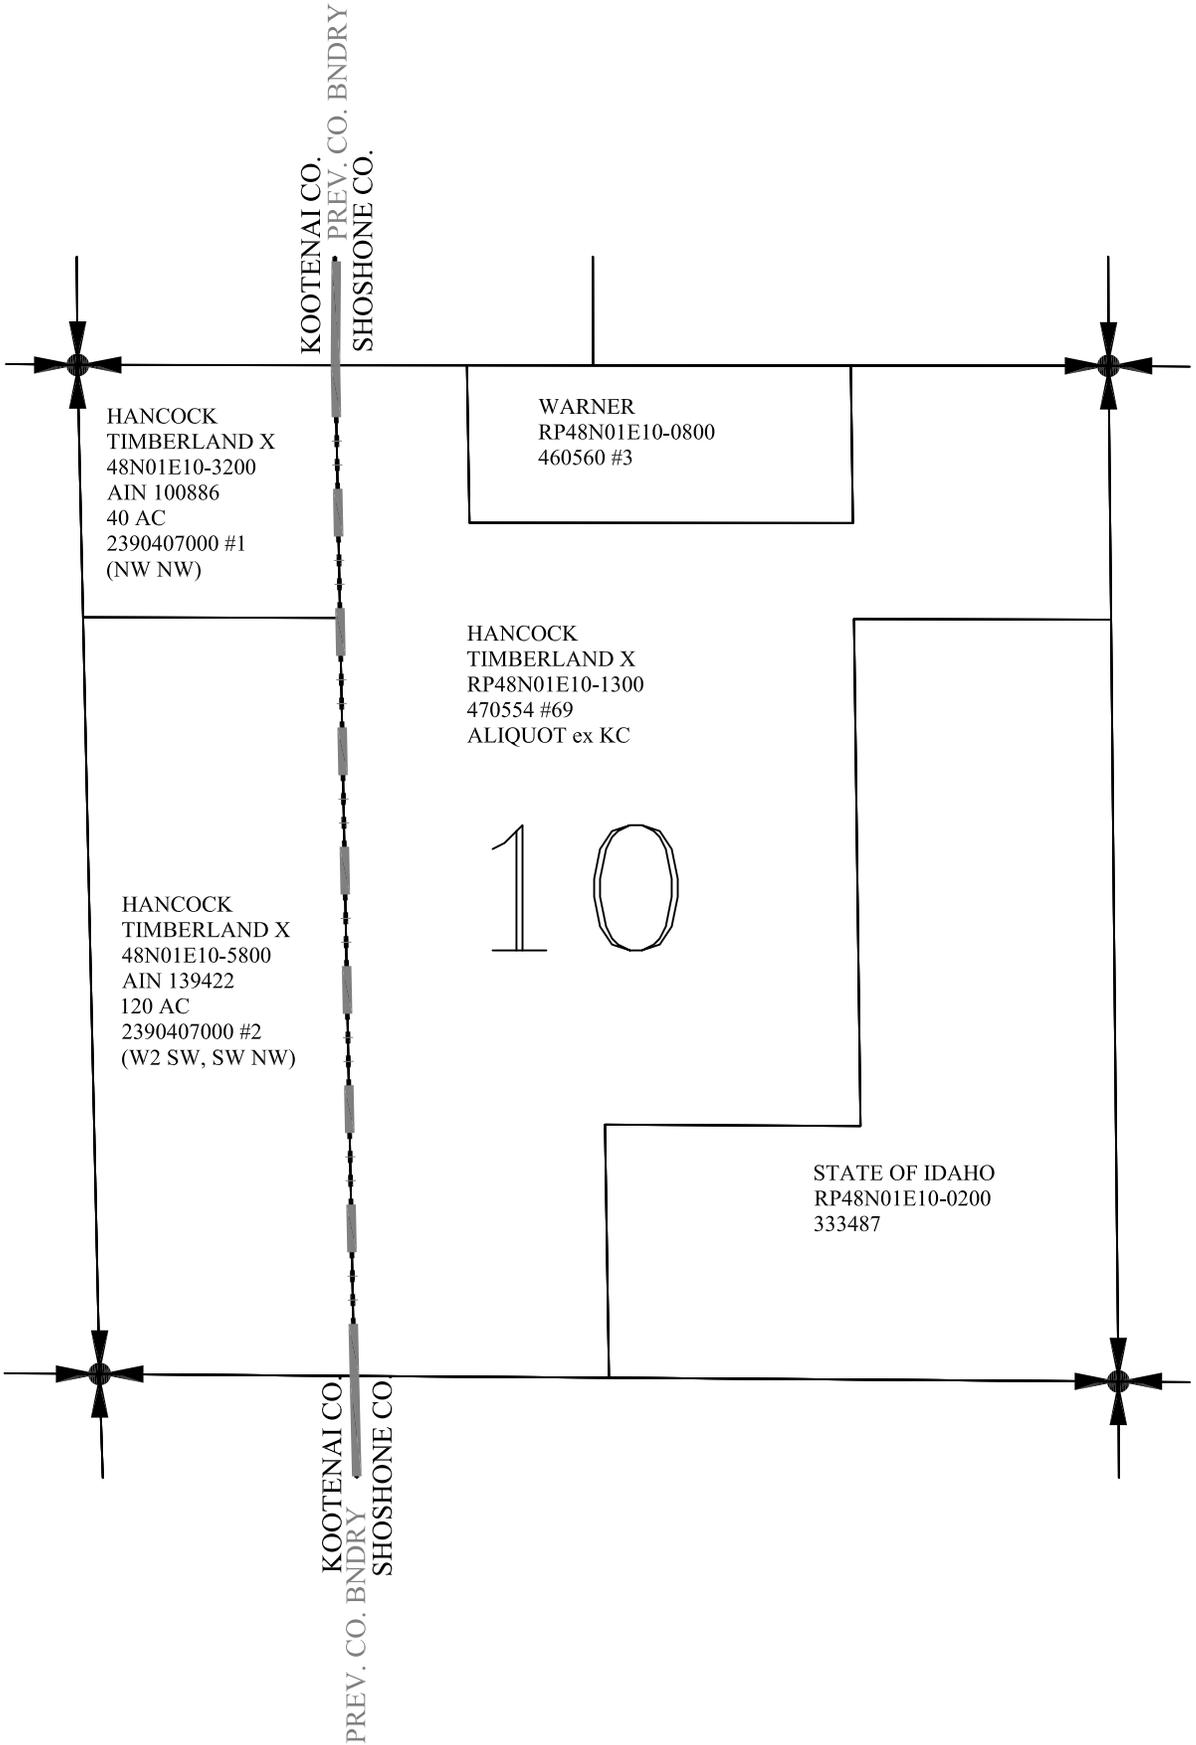

SEC 10, T48N, R1E

1" = 1,000'

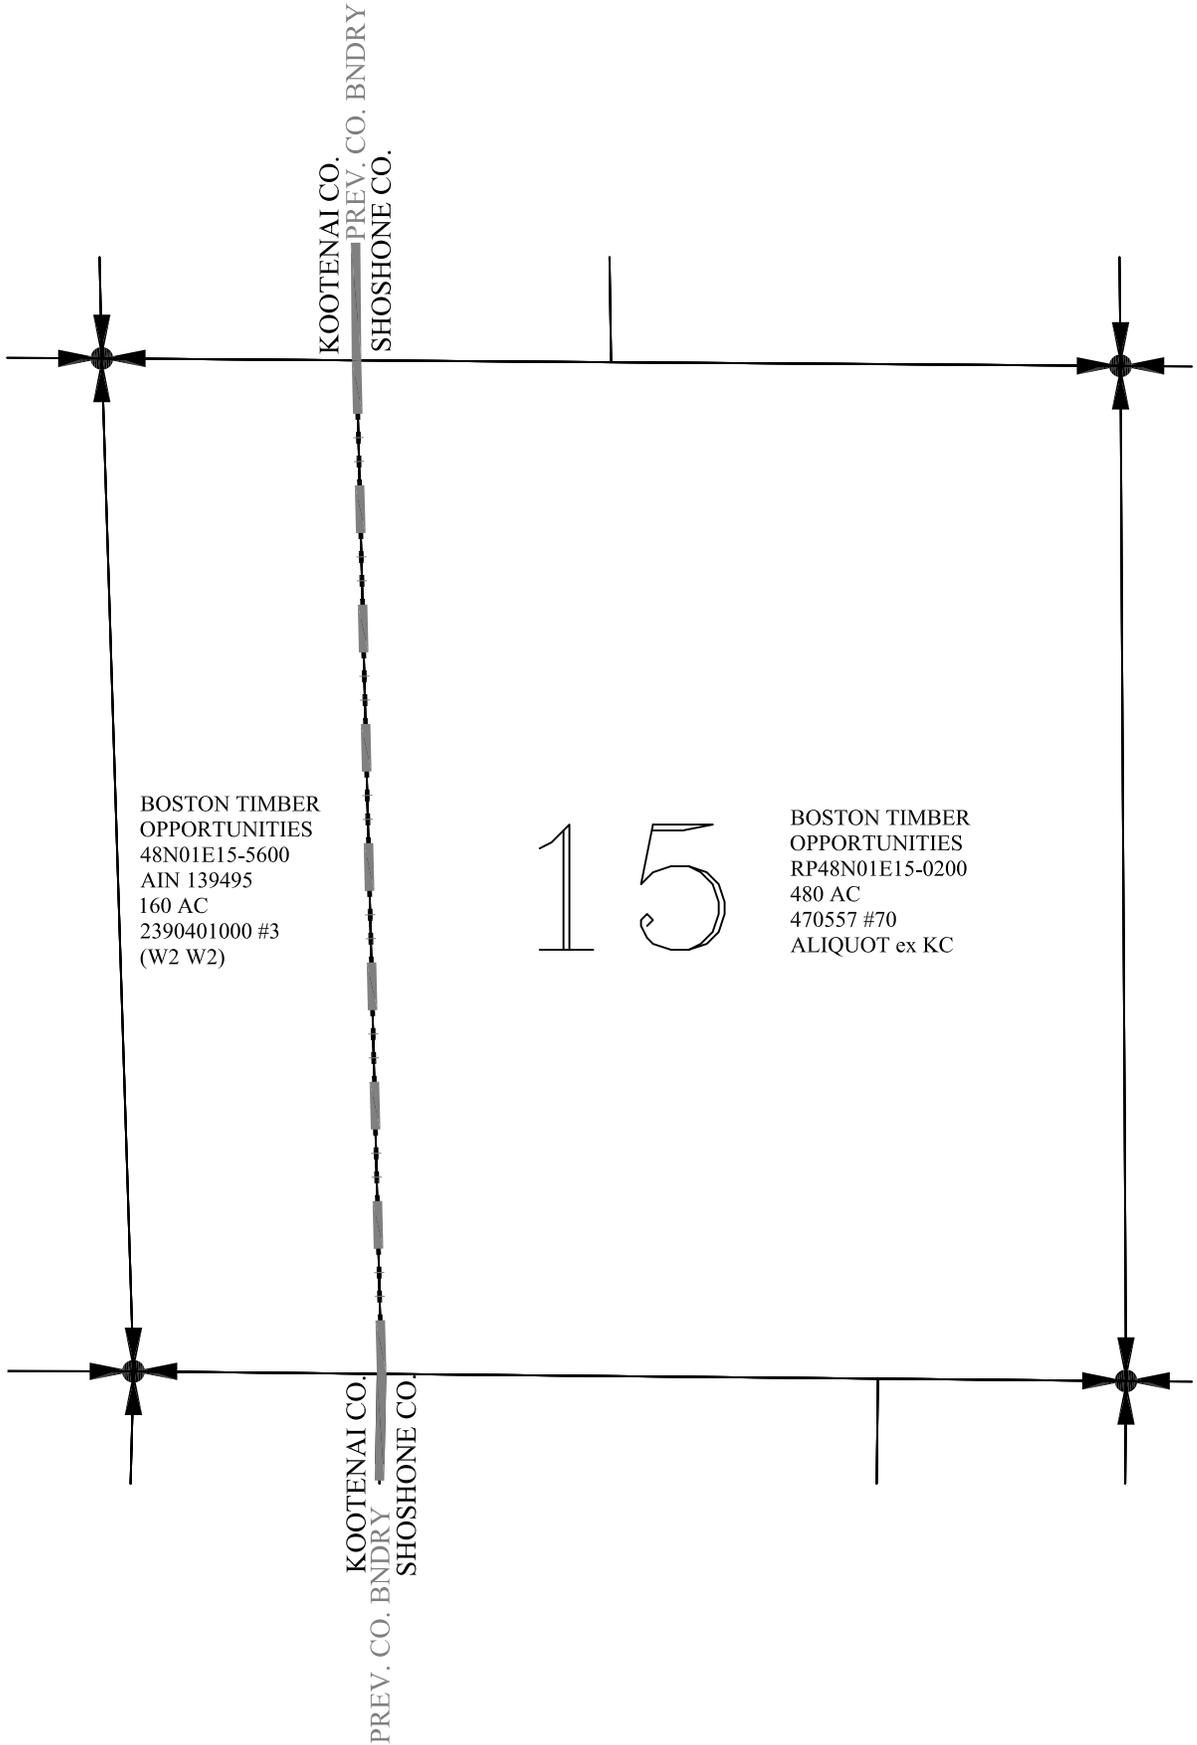


BOSTON TIMBER  
OPPORTUNITIES  
48N01E15-5600  
AIN 139495  
160 AC  
2390401000 #3  
(W2 W2)

15

BOSTON TIMBER  
OPPORTUNITIES  
RP48N01E15-0200  
480 AC  
470557 #70  
ALIQUOT ex KC


SEC 15, T48N, R1E

1" = 1,000'

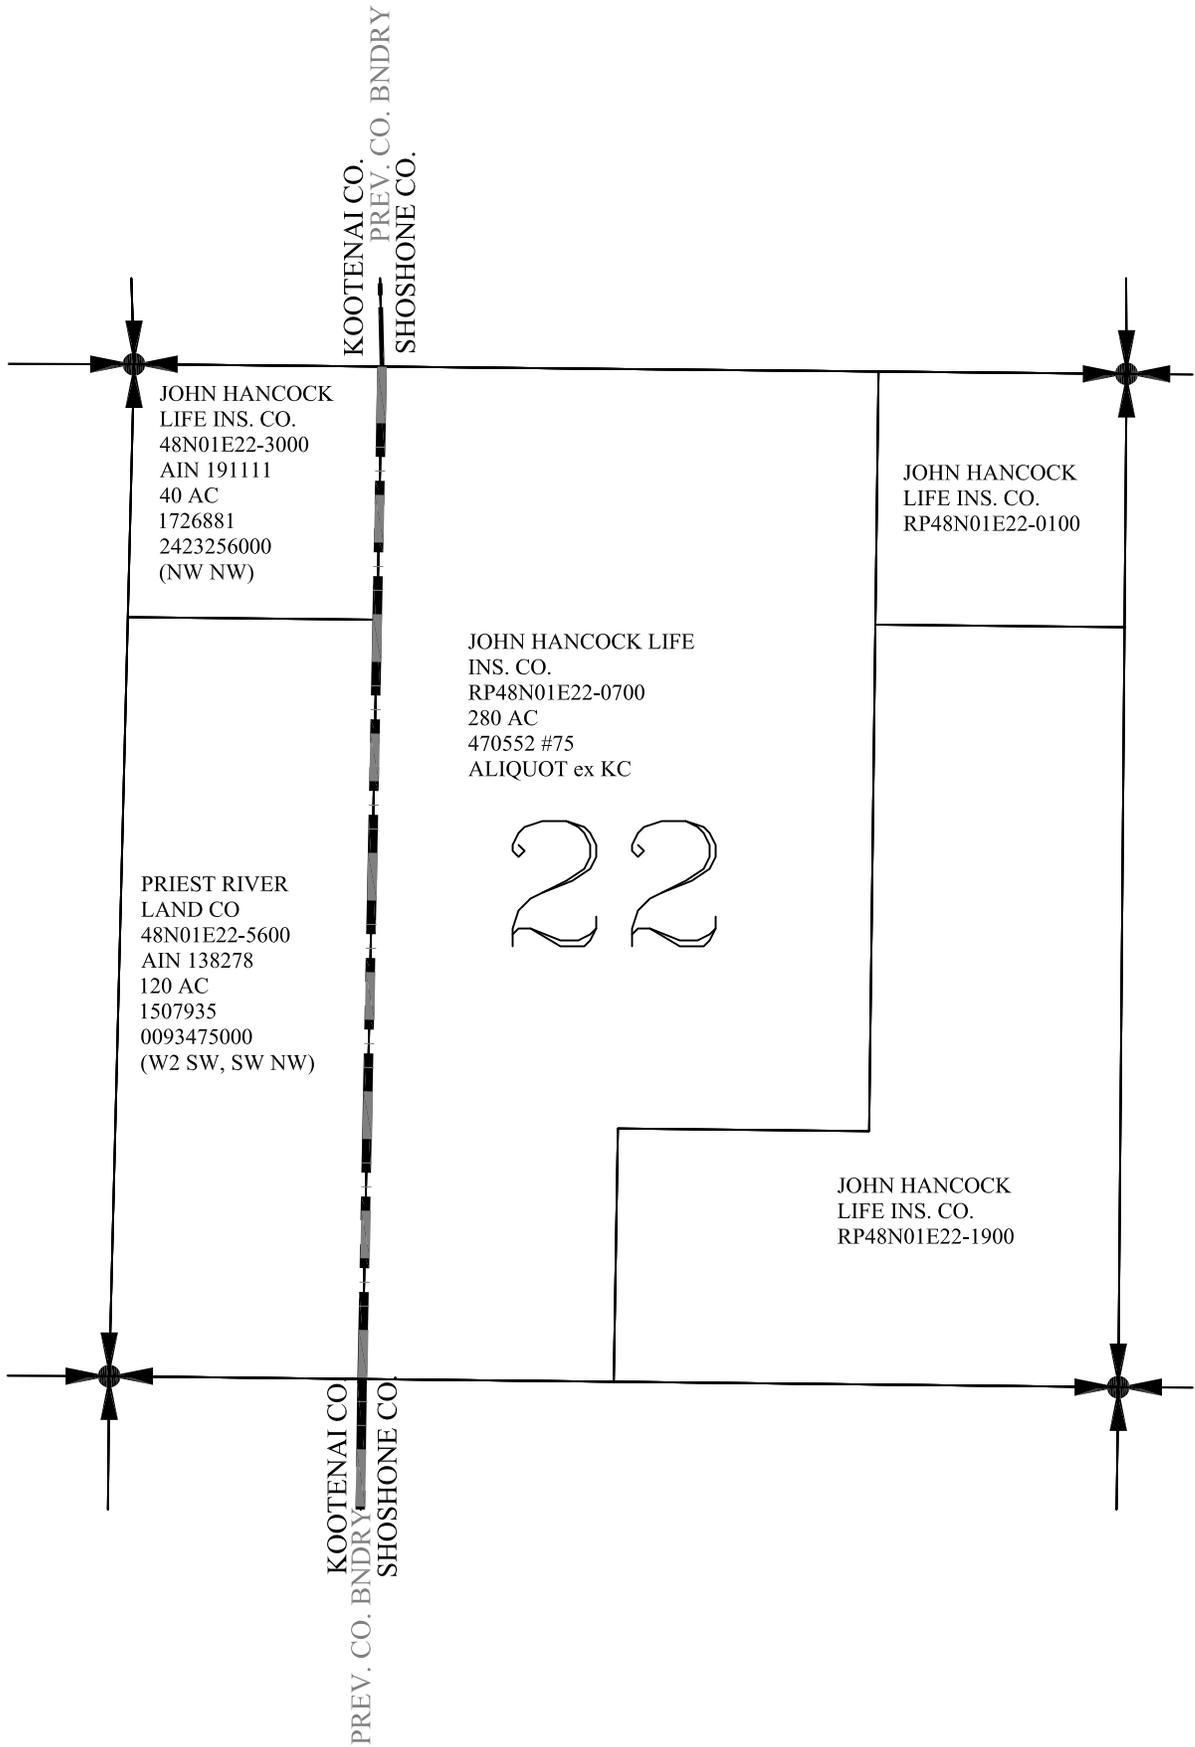

SEC 22, T48N, R1E

1" = 1,000'

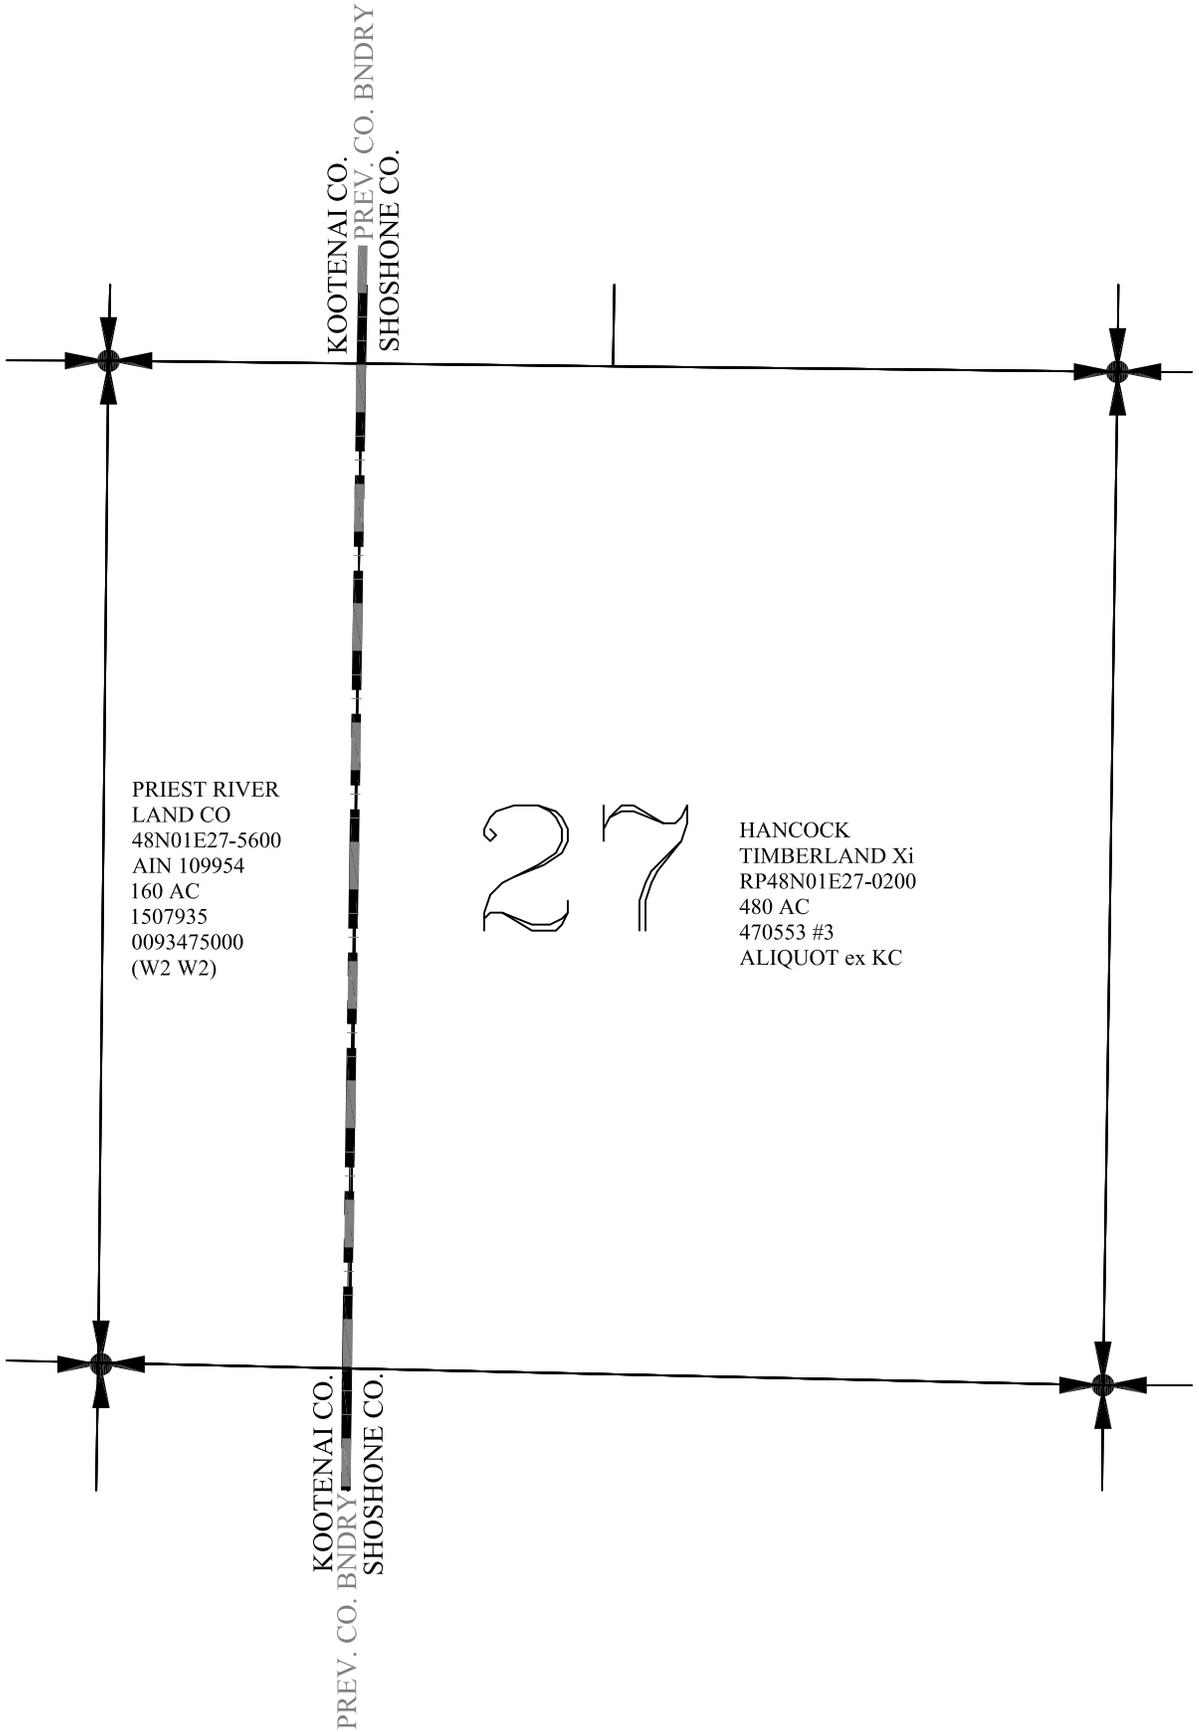


PRIEST RIVER  
 LAND CO  
 48N01E27-5600  
 AIN 109954  
 160 AC  
 1507935  
 0093475000  
 (W2 W2)

27

HANCOCK  
 TIMBERLAND Xi  
 RP48N01E27-0200  
 480 AC  
 470553 #3  
 ALIQUOT ex KC

SEC 27, T48N, R1E


1" = 1,000'

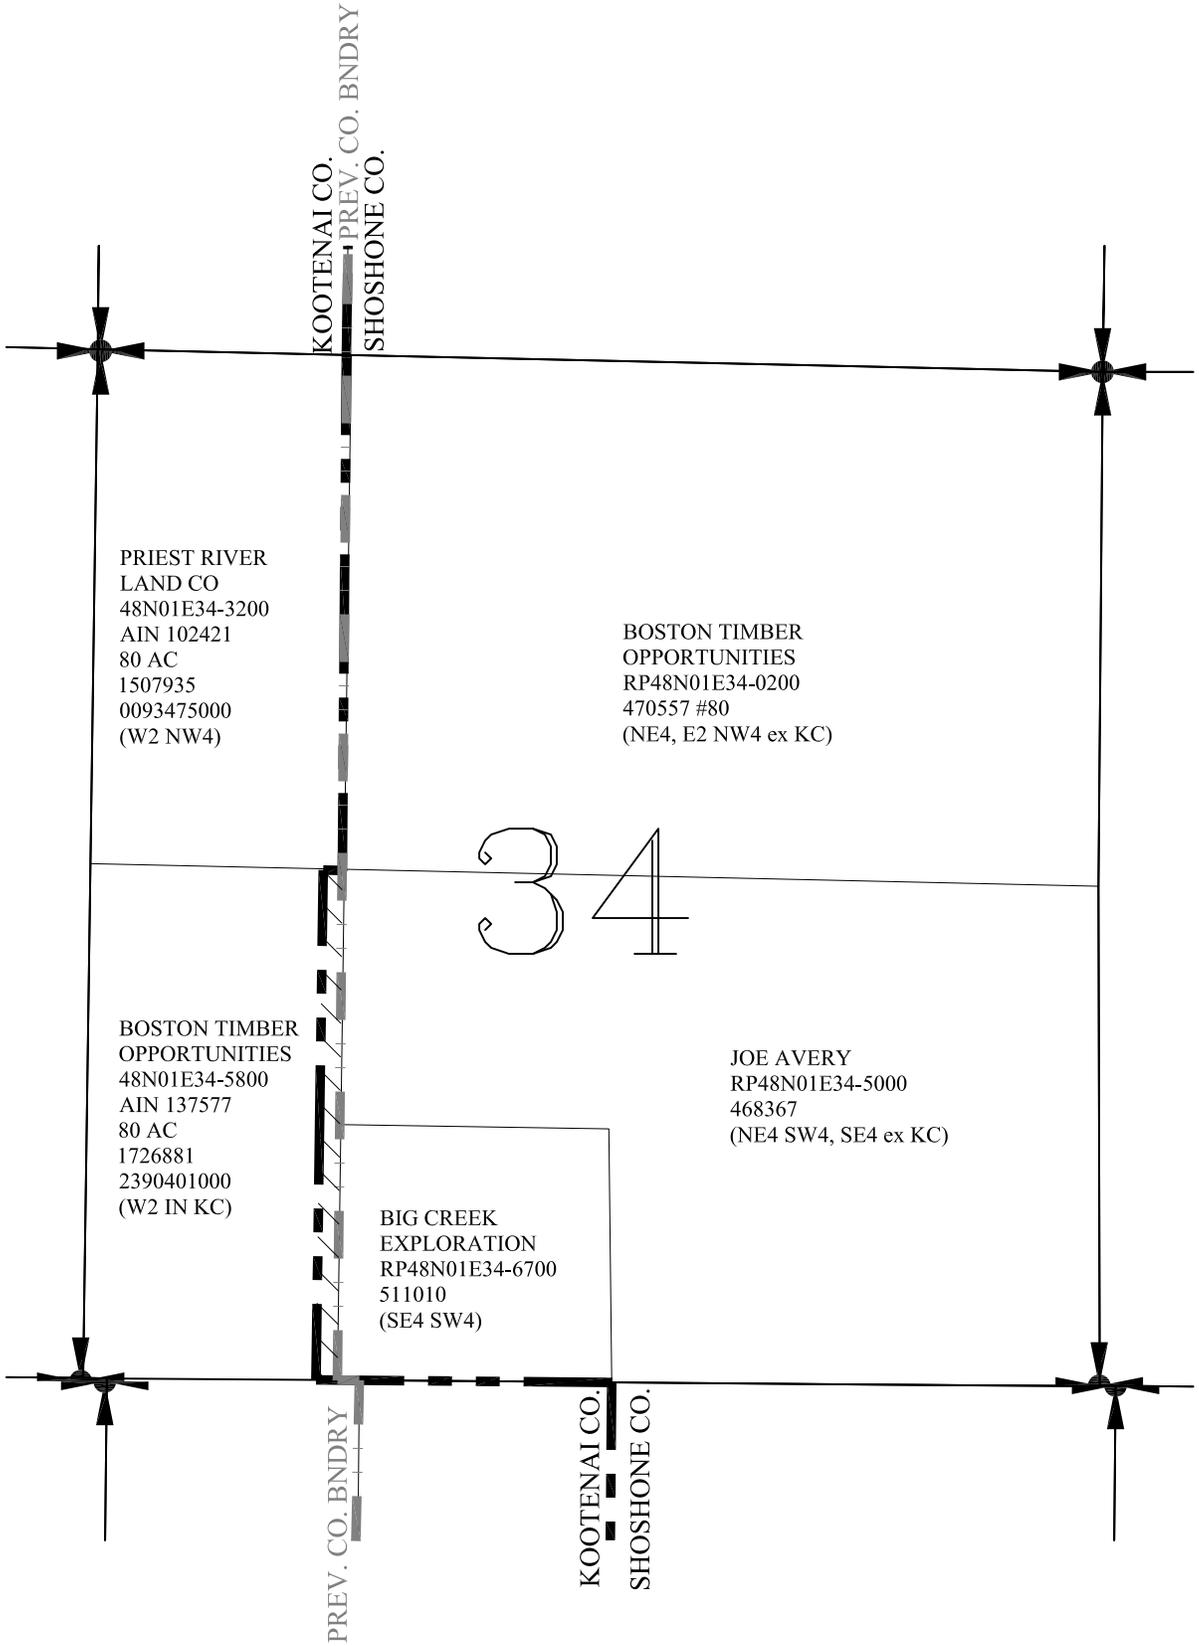



 NEW PARCEL IN  
 SHOSHONE IN THE  
 NAME OF BOSTON  
 TIMBER

# SEC 34, T48N, R1E

1" = 1,000'

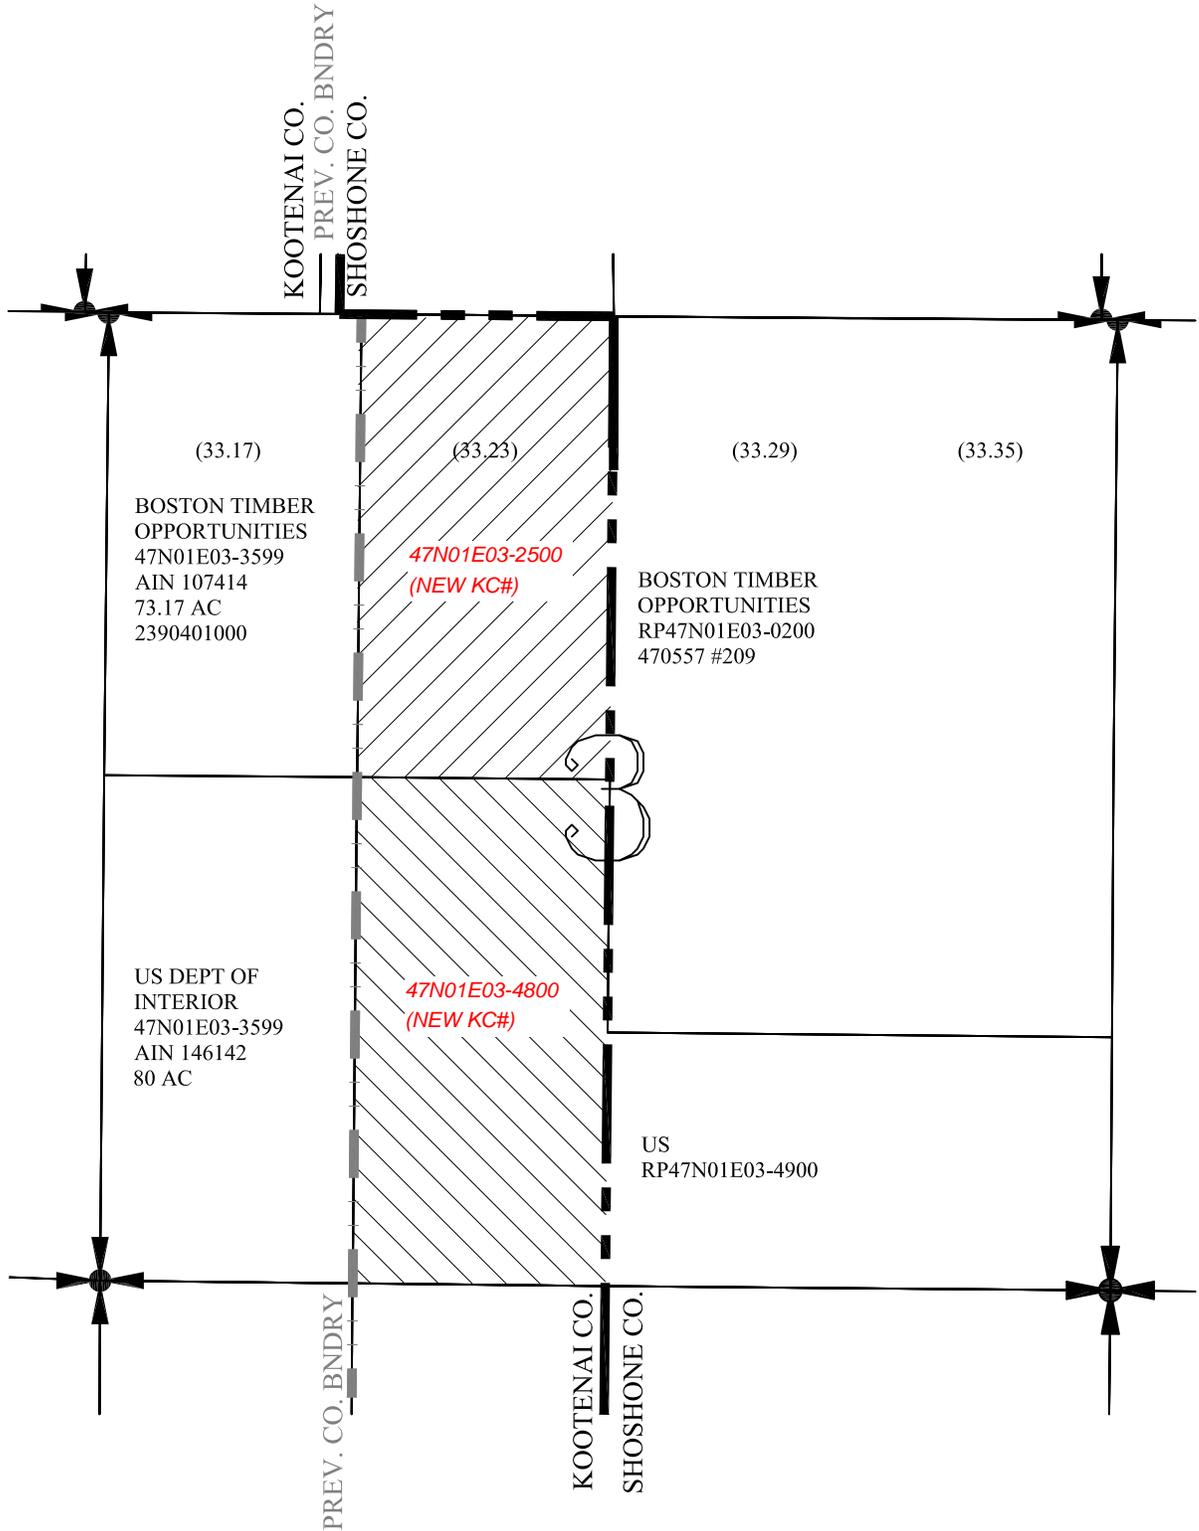


73.23 AC OF  
 RP47N01E03-0200  
 NOW LYING IN  
 KOOTENAI CO.  
 226.64 AC REMAINDER  
 IN SHOSHONE

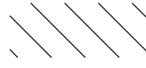


80 AC OF  
 RP47N01E03-0200  
 NOW LYING IN  
 KOOTENAI CO.  
 80 AC REMAINDER  
 IN SHOSHONE

SEC 03, T47N, R1E

1" = 1,000'

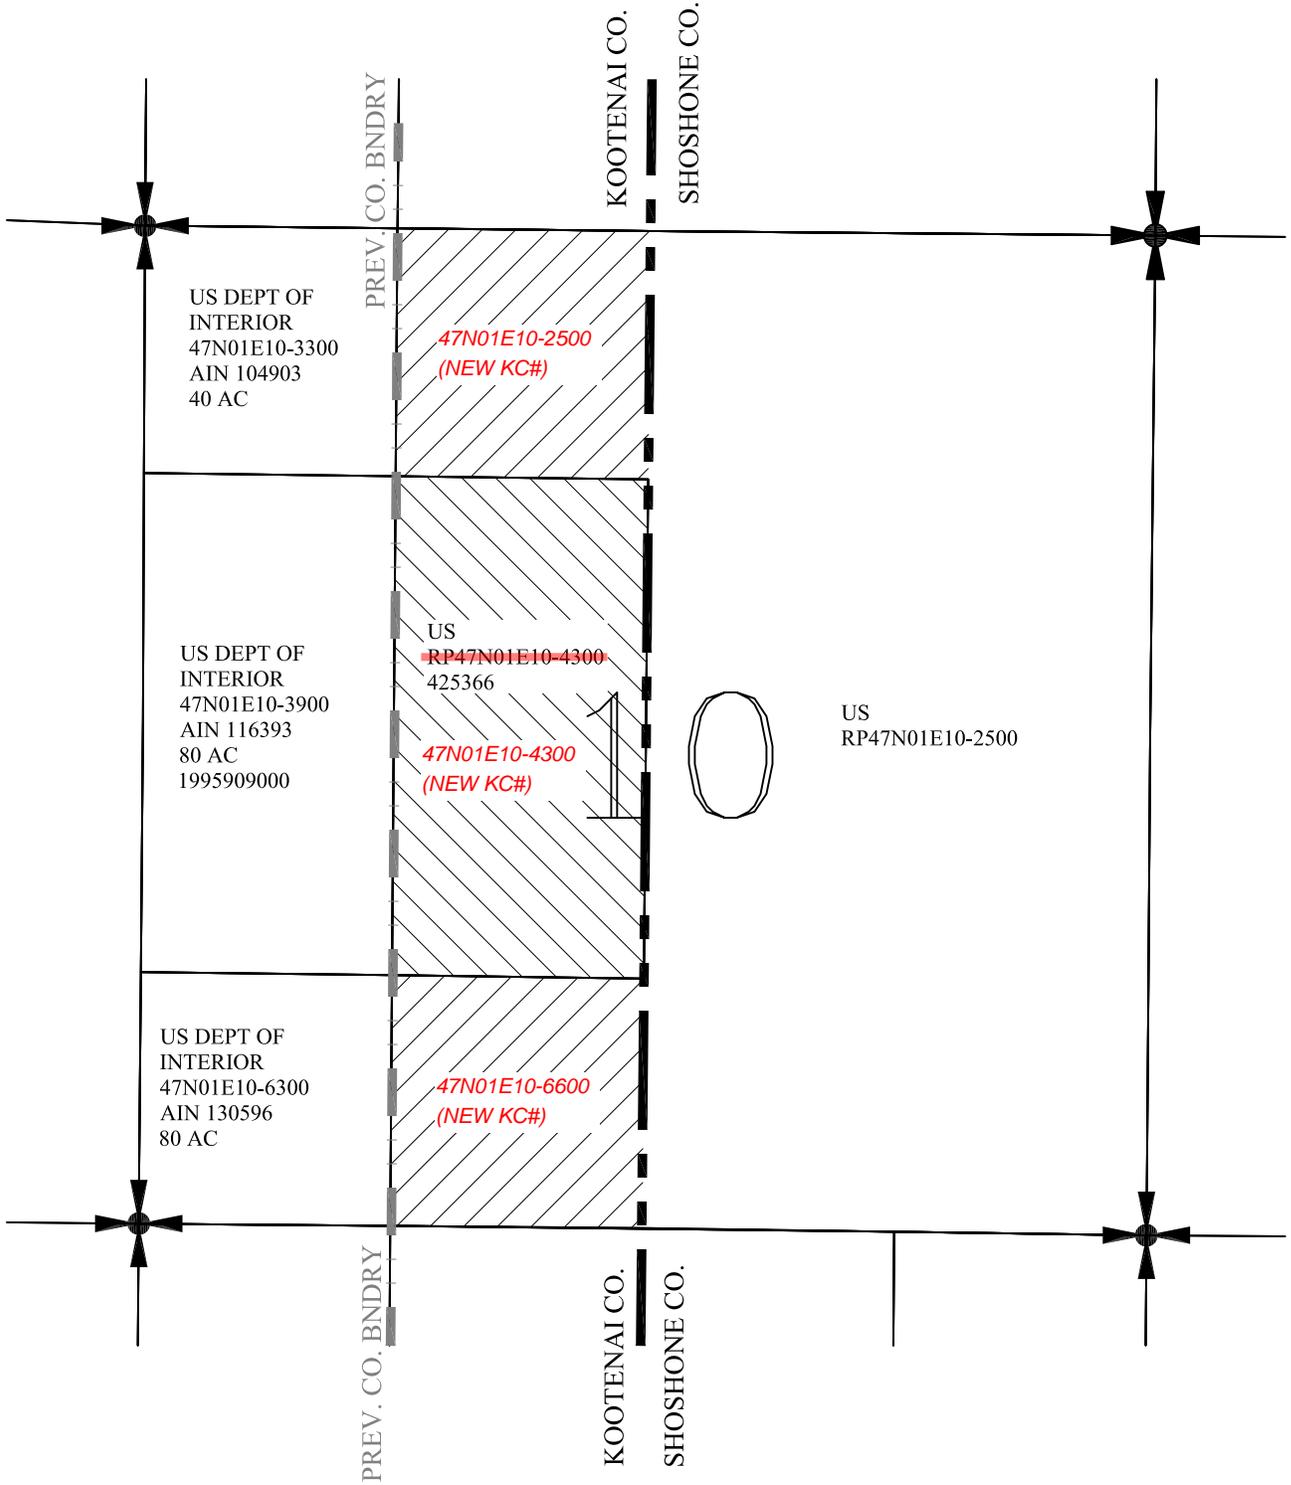

80 AC OF  
 RP47N01E10-2500  
 NOW LYING IN  
 KOOTENAI CO.  
 320 AC REMAINDER  
 IN SHOSHONE

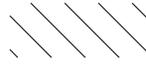

ALL OF RP47N01E10-4300  
 NOW LYING IN  
 KOOTENAI CO.

SEC 10, T47N, R1E

1" = 1,000'



PREV. CO. BNDRY

KOOTENAI CO.

SHOSHONE CO.

HECLA LIMITED  
47N01E15-3300  
AIN 118925  
40 AC  
1162273000

US DEPT OF  
INTERIOR  
47N01E15-3900  
AIN 32642  
40 AC

US DEPT OF  
INTERIOR  
47N01E15-5700  
AIN 119805  
80 AC  
1159045000

47N01E15-2500  
(NEW KC#)

15

US  
RP47N01E15-0700  
470557 #70  
(includes E90' of  
W2W2 but excepts  
any ptn in KC)

US  
RP47N01E15-0200

KOOTENAI CO.  
BENEWAH CO.

BENEWAH CO.

SHOSHONE CO.



160 AC OF  
RP47N01E15-0700  
NOW LYING IN  
KOOTENAI CO.  
280 AC REMAINDER  
IN SHOSHONE

# SEC 15, T47N, R1E